

Maroon

Form 51-5M-9-28-27423

Map No. **KANSAS** Sec. *21* Twp. *21^S* R. *4^E*

Well No. *9 - Sellers (Sellers)* Farm
White Oil Co Company

NORTH

				⊙			

WEST

EAST

SOUTH

Location.....

Drilling Remarks

.....

.....

Rig Up.....

Drilling Remarks

.....

.....

RECORD

Cased..... in..... ft.

Sand.....

Gas.....

Oil.....

Total Depth.....

PRODUCTION

1st 24 hrs. Nat.....

1st 24 hrs. after shot.....

Gas..... cu. ft.....

Dry Hole.....

Abandoned.....

Map No. Sec. Twp. R.

Well No. Farm


..... Company

..... Ft. from N. Line

..... Ft. from S. Line

..... Ft. from E. Line

..... Ft. from W. Line

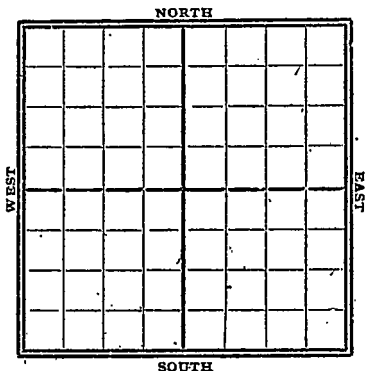

1920

Date

REPORT

Gypsy Records

12/6

Abd T.D. 2460'

Marion
K23 KANSAS MAP NO. SEC. 71 TWP. 21S R. 1E

WELL No. 9 Miller
White Oil Co COMPANY

CONTRACTOR

SECTION PLAT

ABANDONED

		e	

_____ FT. FROM N. LINE

_____ FT. FROM S. LINE

_____ FT. FROM E. LINE

_____ FT. FROM W. LINE

RECORD

LOCATION _____

CASED _____ IN., _____ FT.

RIG UP _____

SAND _____

DRILLING AND REMARKS:

GAS _____

OIL _____

TOTAL DEPTH 2460

PRODUCTION

1ST 24 HRS. NAT. _____

1ST 24 HRS. AFTER SHOT _____

GAS _____ CU. FT.

DRY HOLE _____

ABANDONED _____

DATE

Dec 6 1920

SCOUT