
FORM 51 Lyon

KANSAS

Section 21 Township 21 Range 10E

Well No. 1 Mackey

Company Stewart Oil

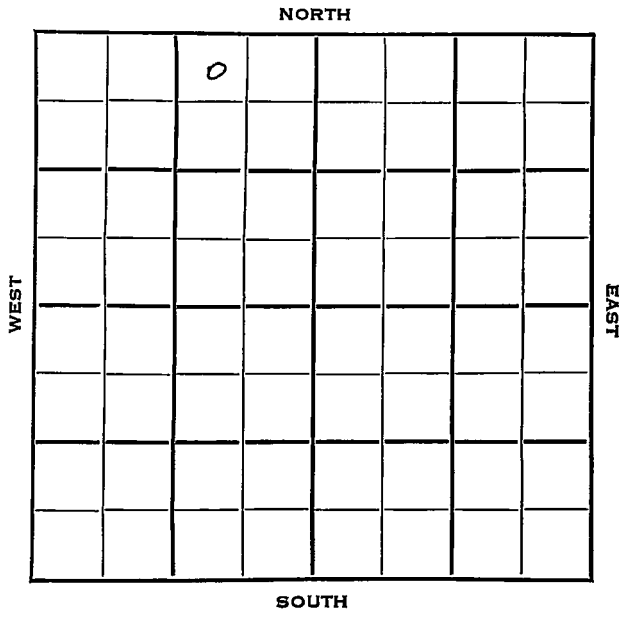

FORM 252-B

Lyon KANSAS ✓

Sec. 21 Twp. 21 R. 10E

Well No. #1 Mackey Farm

Stewart Oil Company

White & Ellis Contractor


330 Ft. from N. Line

Ft. from S. Line

1165 Ft. from E. Line

Ft. from W. Line

NW NE NW

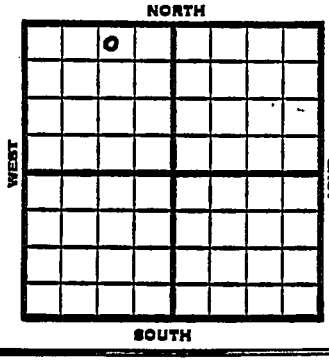

1952 Elev. - REPORT

12/17 Location

1953

1/14 Spud 1-1-53
D&A TD 2271
8" @ 100
Lans 1216, KC 1426, B KC 1633,
Bart 2071, Miss 2250
TD 2271
D&A

ABANDONED

FORM 275 FOR SALE BY KANSAS BLUE PRINT CO.


County Lyon State Kansas

Sec. 21 (Blk. Twp.) 21 (Sur. Rge.) 10E Map No.

Operator Stewart Oil

Well No. 1 Farm Mackey

Elev. Location NW NE NW

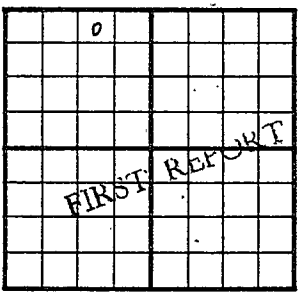

330 Ft. From N Line NW

1165 Ft. From E Line Quarter

1st. Report DEC 17 1952

Completion

Remarks White & Ellis - Contr.

Spudding Date

Drlg. Data

Location

J. G. McGEHEE

FORM 275 FOR SALE BY KANSAS BLUE PRINT CO.


County Lyon State Kansas

Sec. 21 (Blk. Twp.) 21 (Sur. Rge.) 10E Map No.

Operator Stewart Oil

Well No. 1 Farm Mackey

Elev. Location NW NE NW

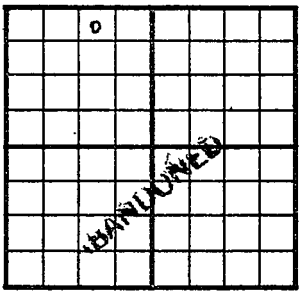

330 Ft. From N Line NW

1165 Ft. From E Line Quarter

1st. Report

Completion JAN 1 4 1953

Remarks

White & Ellis - Contr.

Spudding Date 1-1-53

Drlg. Data D & A TD 2271

8" @ 100 Lans. 1216 KC 1426

B KC 1633 Bart. 2071 Miss. 2250

TD 2271

D & A

J. G. McGEHEE