

Map No. Sec. Twp. R.

Well No. Farm


..... Company

..... Ft. from N. Line

..... Ft. from S. Line

..... Ft. from E. Line

..... Ft. from W. Line

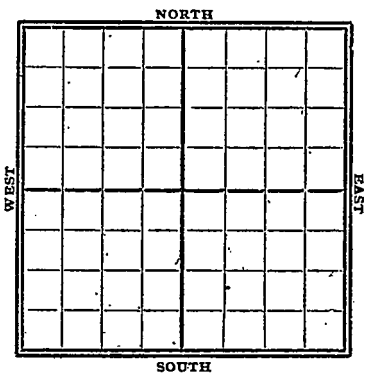

1920

Date

REPORT

Gypsy Records

12/16

Abd T.D. 600'

K23 MAP NO. KANSAS, SEC. 71 TWP. 51S R. 1E

WELL NO. 6 Miller

Ramsay Pet COMPANY

CONTRACTOR

SECTION PLAT

ABANDONED

	0		

_____ FT. FROM N. LINE

_____ FT. FROM S. LINE

_____ FT. FROM E. LINE

_____ FT. FROM W. LINE

RECORD

LOCATION ✓

CASED _____ IN. _____ FT.

RIG UP _____

SAND _____

DRILLING AND REMARKS:

GAS _____

OIL _____

TOTAL DEPTH 600

*over
are shown
700*

PRODUCTION

1ST 24 HRS. NAT. _____

1ST 24 HRS. AFTER SHOT _____

GAS _____ CU. FT.

DRY HOLE _____

ABANDONED ✓

DATE

Dec 6 1920

SCOUT