

KANSAS

State Geological Survey  
WICHITA, BRANCH

WELL COMPLETION REPORT AND  
DRILLER'S LOG

API No. 15 — 107 — 20,945  
County Number

Operator  
L&L Enterprises, Inc.

Address  
P.O. Box 85 Derby, Kansas 67037

Well No. 2 Lease Name Florence Gorrell


Footage Location  
850 feet from (S) line 1,080 feet from (W) line of SW  $\frac{1}{4}$

Principal Contractor Exploration, Inc. Geologist

Spud Date 1-13-81 Date Completed 8-28-81 Total Depth 510 P.B.T.D.

Directional Deviation Oil and/or Gas Purchaser  
Maclaskey

91 Ind  
S. 7T. 21SR.22 (E)  
850' fsl & 1080'  
Loc. fwl of the SW  $\frac{1}{4}$   
County Linn

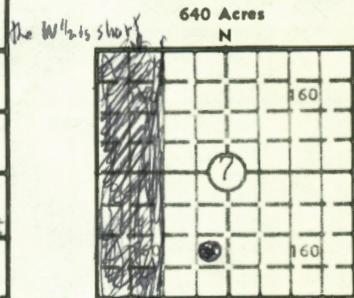

640 Acres  
N  
Locate well correctly  
Elev.: Gr. + 901  
DF \_\_\_\_\_ KB \_\_\_\_\_

CASING RECORD

Report of all strings set — surface, intermediate, production, etc.

Purpose of string	Size hole drilled	Size casing set (in O.D.)	Weight lbs/ft.	Setting depth	Type cement	Sacks	Type and percent additives
Surface	7 7/8	6 1/4	17	20	Portland	5	
Production	5 1/8	line pipe 2"	3.75	507	"	65	Prem Gel 2 sx.

LINER RECORD

PERFORATION RECORD

Top, ft.	Bottom, ft.	Sacks cement	Shots per ft.	Size & type	Depth interval
			2	1 1/16 glass & alum jets	480-491

TUBING RECORD

Size	Setting depth	Packer set at

ACID, FRACTURE, SHOT, CEMENT SQUEEZE RECORD

Amount and kind of material used	Depth interval treated
90 sacks sand and 200 bbls of water	480-491

INITIAL PRODUCTION

Date of first production	Producing method (flowing, pumping, gas lift, etc.) <u>pumping</u>		
RATE OF PRODUCTION PER 24 HOURS	Oil <u>approx. 1/2</u> bbls.	Gas MCF	Water <u>app. 1/3</u> bbls.
Disposition of gas (vented, used on lease or sold)		Gas-oil ratio CFPB	
		Producing interval (s)	

INSTRUCTIONS: As provided in KCC Rule 82-2-125, within 90 days after completion of a well, one completed copy of this Drillers Log shall be transmitted to the State Geological Survey of Kansas, 4150 Monroe Street, Wichita, Kansas 67209. Copies of this form are available from the Conservation Division, State Corporation Commission, 245 No. Water, Wichita, Kansas 67202. Phone AC 316-522-2206. If confidential custody is desired, please note Rule 82-2-125. Drillers Logs will be on open file in the Oil and Gas Division, State Geological Survey of Kansas, Lawrence, Kansas 66044.

Operator

L&L Enterprises, Inc.

DESIGNATE TYPE OF COMP.: OIL, GAS, DRY HOLE, SWDW, ETC.:

Well No.

2

Lease Name

Florence Gorrell

oil

S 7 T 21 R 22 E W

WELL LOG

Show all important zones of porosity and contents thereof; cored intervals, and all drill-stem tests, including depth interval tested, cushion used, time tool open, flowing and shut-in pressures, and recoveries.

SHOW GEOLOGICAL MARKERS, LOGS RUN, OR OTHER DESCRIPTIVE INFORMATION.

FORMATION DESCRIPTION, CONTENTS, ETC.	TOP	BOTTOM	NAME	DEPTH
Clay	0	10		
Ls	10	23		
Sh Blk	23	30		
Ls	30	70		
Sh Blk.	70	80	B/KC	110
Ls	80	95		
Sh	95	100	Altamont	304
Ls	100	110		
Sh Blue & grey	110	275	Ft. Scott	423
Sh Blk.	275	280		
Sh grey	280	305	B/Ck. Sh.	471
Ls	305	312		
Sh Blk.	312	315	Squirrel Sd.	480
Sh Bl. & grey	315	365		
Ls	365	380		
Sh Blue	380	390		
Ls	390	395		
Sh Blk.	395	398		
Sh grey	398	422		
Ls	422	440		
Sh	440	450		
Ls	450	457		
Sh Blk.	457	460		
Sh grey	460	470		
Sh blk.	470	475		
Sh	475	482		
Sd (oil)	482	495		
Sh grey	495	510		

Cored: 482-495

USE ADDITIONAL SHEETS, IF NECESSARY, TO COMPLETE WELL RECORD.

Date Received

*[Signature]*

Signature

*Pratt Exploration Co*

Title

8/28/82

Date

54383