




9-21-22 E 0
 Should be in
 SW 1/4 NW
 750' from west
 300' " north
 Plotted
 R.S.

SAUNDERS NO. - DRW -

SW NW
~~SE 1/4, NW 1/4~~, Section 9, 21-22, Linn County, Kans.

Soil, drk	4
shell lime	14
shale, brn	18
lime	20
shale	37
lime	45
shale	95
lime	110
shale	114
lime, wht <i>exc</i>	147
shale, blue	155
lime	160
shale, drk-water-	165
lime	180
shale, blk -water-	185
lime	198
shale <i>exc</i>	375
lime	385
shale	435
lime	450
shale	465
lime <i>exc</i>	470
shale, blue	493
lime	497
shale, blue	517
shale	523
lime	526
shale, blk	551
shale, grey	560
shale	569
sand & short brakers	599
oil sand, brkn <i>Squirrel</i>	616
shale, blue	626

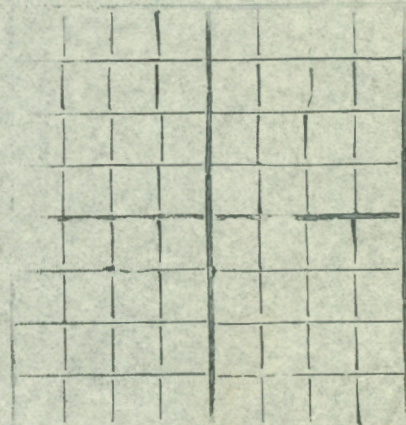

Sec. _____
 Twp. _____
 Rge. _____
 Elev. _____
 Cmpd. _____

X