


Southwestern Petroleum Co. 11-21S-22E Early wells

SW/4
Linn Co.

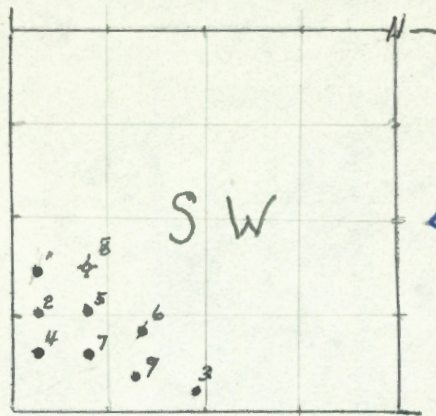

Relative locations

← SW/4 11-21-22E

Linn COUNTY

SAND RECORDS

#	1	2	3	4	5	6	7	8	9
		456	471 gas - 497 oil	452	475 " - 507 "	452	480 " - 500 "	456	475 " - 500 "
						455	472 " - 500 "		
						458	480 " - 504 "		
								no log	dry
									458 468 " - 500 "

oil)

approx loc.

W/2 NW SW SW

C W/2 W/2 SW SW

SE SE SW SW

W/2 SW SW SW

C E/2 W/2 SW SW

NW SE SWSW

E/2 SW SW SW

E/2 NW SW SW

W/2 SE SWSW