Southwestern Petroleum Co. 11-21S-22E
Early wells
SW/4
Linn Co.

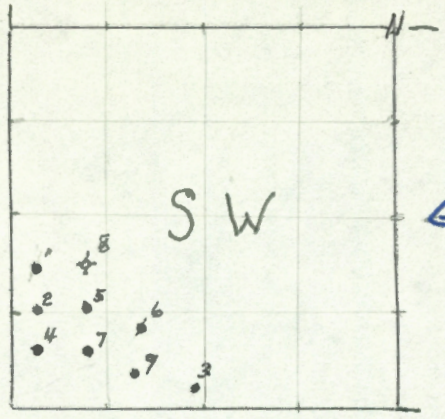

← SW/4 - 11-21-22E
Linn County

Relative locations

SAND RECORDS

				approx loc.
* 1			oil	W/2 NW SW SW
# 2	456	471 gas	- 497 oil	C W/2 W/2 SW SW
# 3	452	475 "	- 507 "	SE SE SW SW
# 4	452	480 "	- 500 "	W/2 SW SW SW
# 5	456	475 "	- 500 "	C E/2 W/2 SW SW
# 6	455	472 "	- 500 -	NW SE SW SW
# 7	458	480 "	- 504 "	E/2 SW SW SW
# 8	no log	dry		E/2 NW SW SW
# 9	458	468 "	- 500 "	W/2 SE SW SW