

State Geological Survey
WICHITA, BRANCH

KANSAS DRILLERS LOG

S. 10 T. 21 R. 22 E W

API No. 15 — 107 — 20,541
County Number

Loc. NW SE SE

County Linn

Operator
Hastert Oil Company

Address
Route #1 Garnett, Kansas 66032


Well No. #4 Lease Name Hill

Footage Location
feet from (N) (S) line feet from (E) (W) line

Principal Contractor Kent Drilling Co. Geologist

Spud Date June 16-1975 Total Depth 570 P.B.T.D.

Date Completed June 20-1975 Oil Purchaser Bluebird Oil Co.

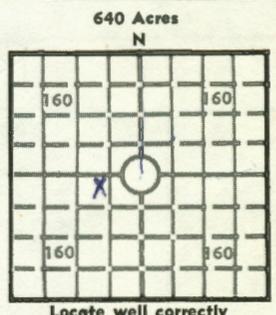

Elev.: Gr.

DF KB

CASING RECORD

Report of all strings set— surface, intermediate, production, etc.

Purpose of string	Size hole drilled	Size casing set (in O.D.)	Weight lbs./ft.	Setting depth	Type cement	Sacks	Type and percent additives
Production Casing	6 1/4"	4"		567'	Portland	70	

LINER RECORD

PERFORATION RECORD

Top, ft.	Bottom, ft.	Sacks cement	Shots per ft.	Size & type	Depth interval
			1		512-548

TUBING RECORD

Size	Setting depth	Packer set at

ACID, FRACTURE, SHOT, CEMENT SQUEEZE RECORD

Amount and kind of material used	Depth interval treated
Fracture - 80 bbls Lease oil & 11 SKS SAND	512-548

INITIAL PRODUCTION

Date of first production 7-20-75	Producing method (flowing, pumping, gas lift, etc.) pumping			
RATE OF PRODUCTION PER 24 HOURS	Oil 1 bbls.	Gas — MCF	Water — bbls.	Gas-oil ratio — CFPB
Disposition of gas (vented, used on lease or sold)		Producing interval(s)		

INSTRUCTIONS: As provided in KCC Rule 82-2-125, within 90 days after completion of a well, one completed copy of this Drillers Log shall be transmitted to the State Geological Survey of Kansas, 4150 Monroe Street, Wichita, Kansas 67209. Copies of this form are available from the Conservation Division, State Corporation Commission, 3830 So. Meridian (P.O. Box 17027), Wichita, Kansas 66217. Phone AC 316-522-2206. If confidential custody is desired, please note Rule 82-2-125. Drillers Logs will be on open file in the Oil and Gas Division, State Geological Survey of Kansas, Lawrence, Kansas 6044.

