


Southwestern Petroleum Co. 11-21S-22E Early wells

SW/4
Linn Co.

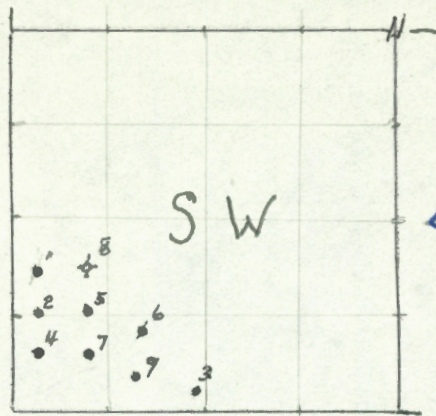

Relative locations

← SW/4 11-21-22E

Linn COUNTY

SAND RECORDS

# 1				oil)
# 2	456	471 gas	- 497 oil	
# 3	452	475 "	- 507 "	
# 4	452	480 "	- 500 "	
# 5	456	475 "	- 500 "	
# 6	455	472 "	- 500 "	
# 7	458	480 "	- 504 "	
# 8	no log	dry		
# 9	458	468 "	- 500 "	

approx loc.

W/2 NW SW SW

C W/2 W/2 SW SW

SE SE SW SW

W/2 SW SW SW

C E/2 W/2 SW SW

NW SE SWSW

E/2 SW SW SW

E/2 NW SW SW

W/2 SE SWSW