

Plotted

14-21-22 E 0

Company Texas

Sec. 14 T. 21 R. 22
Loc. S $\frac{1}{2}$, NW $\frac{1}{4}$ & SW $\frac{1}{4}$? NE $\frac{1}{4}$

Farm D.A. Lee

No. 2

Total Depth 473

County Linn


Comm.

Comp. 7/12/20

Shot or Treated

Contractor

Issued

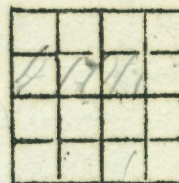

Casing

20 in.	10 in.	
15 1-2	8 1-4	2 $\frac{1}{2}$
12 1-2	6 5-8	
13 3-8	5 3-16	420 $\frac{1}{2}$

Elevation

Production 40 bbl. oil

Figures Indicate Bottom of Formation

Lime Shell, Lt. Hard	10	Lime, Lt. Hard	317
Shale-Lime " "	18	Shale " Soft	330
" Blk. Soft	22	Lime " Hard	335(water)
Lime " Hard	36	Shale Drk. Soft	365
Shale Blue Soft	45	Lime Lt. Hard	371
Lime Lt. Hard	63	Shale " Soft	385
Shale " Soft	65	Lime " Hard	394
Lime " Hard	69	Shale Drk. Soft	397
Shale " Soft	218	Shale Blk. "	401
Lime " Hard	225	" Lt. "	404
Shale " Soft	239	Lime " Hard	405
Lime " Hard	254	Shale " Soft	408
Shale " Soft	305	Lime " Hard	410
		Shale White Soft	427
		Oil Sand Brown Soft	463
		Shale Drk. "	473


(Texaco)

Southwestern Petroleum Company
D.A. Lee Wells

14-21S-22E

LINN Co

Page 2

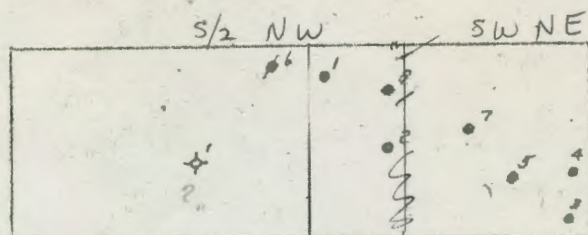


Relative locations

SAND RECORDS

✓ approx NW NW SW NE #1 411 - 451
SE SE SW NE #2 427 - 463
SE SE SW NE #3 440-455 gas - 487 oil
NE NE SW NE #4 426 - 434" - 473"
NW NW SW NE #5 436 - 443" - 466"
NE NE SE NW #6 426 429" - 435" 436 shale - 452 oil
SW NE SW NE #7 363. 370" 404"
approx NW SW NE #8 376 385" 416"

M.J. Kerr	E.A. Kerr
D.A. Lee	

E.A. Kerr Wells
N/2-NE 14-21-22

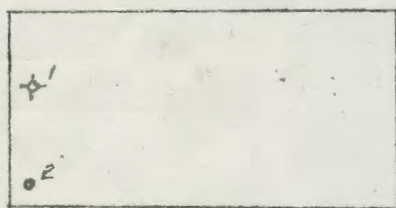

Relative locations

SAND RECORDS

NW NW NE #1 411 - 451
SW NW NE #2 440 - 485

Martha J. Kerr Wells
N/2-NW/4 14-21-22



Relative locations

SAND RECORDS

NW NW NE NW #1 453 - 471 gas - 503 oil
SE SE NW NE NW #2 411 - 425 gas 429 sh. - 460
C NE NW #3 440 - 448 bkn. - 469 gas - 472
CS 1/2 NE NW #4 440 - 455 gas - 477 oil