


14-21-22E⁰✓

Location SE SE SW

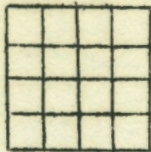

Sec. 14, T. 21, R. 22^E_W

Farm D. A. Lee No. 3 County Linn

Company Hoskins

Commenced _____ Completed Sept. 21, 1920

Elevation _____ T.D. 489 I. P. _____

PLOTTED LOG ONLY

(Texaco)


14-215-22E

Southwestern Petroleum Company

D. A. Lee Wells

LINN Co

Page 2

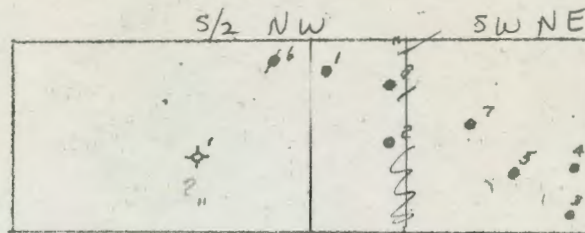

← S/2-NW & SW-NE
14-21-22


Relative locations

SAND RECORDS

NW NW SW NE #1 411-451
 approx NW SW NE #2 427-463
 SE SE SW NE #3 440-455 gas - 487 oil
 NE NE SW NE #4 426-434" - 473"
 NW NW SW NE #5 436-443" - 466"
 NE NE SE NW #6 426 429" - 435" 436 shale - 452 oil
 SW NE SW NE #7 363. 370" 404"
 approx NW SW NE #8 376 385" 416"

M. J. Kerr	E. A. Kerr		
D. A. Lee			

E. A. Kerr Wells
N/2-NE 14-21-22

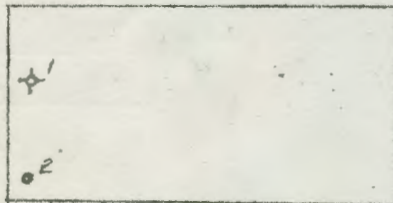


Relative locations

SAND RECORDS

NW NW NE #1 411-451
 SW NW NE #2 440-485

Martha J. Kerr Wells
N/2-NW/4 14-21-22

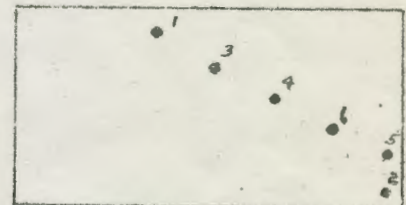

Relative locations

SAND RECORDS

NW NW NE NW #1 453-471 gas - 503 oil
 SE SE NW NE NW #2 411-425 gas 429 sh. - 460
 C NE NW #3 440-448 bkn. - 469 gas - 477
 CS/2 NE NW #4 440-455 gas - 477 oil