

Company Texas

Farm D.A. Lee

No. 6

Total Depth 464

Comm.

Shot or Treated

Contractor

Issued

Comp. 11/6/20


Sec. 14

T. 21

R. 22

Loc. S $\frac{1}{2}$, NW $\frac{1}{4}$, SW $\frac{1}{2}$, NE $\frac{1}{4}$

County Linn

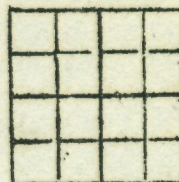

Casing

20 in. 10 in.
15 1-2 8 1-4 8
12 1-2 6 5-8
13 3-8 5 3-16
4 7/8 421

Elevation

Production

Figures Indicate Bottom of Formation

Soil Blk.	Soft	2	Lime, Lt.	Hard	382
Lime Shell, Lt.	"	6	Shale "	"	385
" Lt.	"	21	Lime "	"	389
Shale Blue	"	27	Shale Grey	Soft	394
Lime Lt.	Hard	33	" Blue	"	398
Shale Drk.	Soft	38	" Grey	"	402
Lime Lt.	Hard	44	Lime Lt.	Hard	404
Shale Blue	Soft	50	Shale "	Soft	416
" Lt.	"	205	" White	Hard	426
Lime "	Hard	210	Sand-Gas Lt.	Soft	429
Shale "	Soft	225	" Oil	Hard	435
Lime "	Hard	240	Shale "	Soft	436
Shale	"	295	Oil-Sand Broken	"	452
Lime "	"	310	Shale Drk.	"	464
Shale Blue	Soft	320			
Lime Lt.	Hard	325			
Shale Blue	Soft	355			
" Lt.	Hard	377			

(Texaco)


Southwestern Petroleum Company

D. A. Lee Wells

14-21S-22E

LINN CO

Page 2

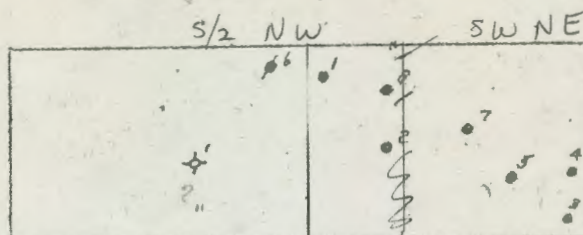

← S/2 NW & SW-NE
14-21-22


Relative locations

SAND RECORDS

NW NW SW NE #1 411 - 451
✓ approx NW SW NE #2 427 - 463
SE SE SW NE #3 440-455 gas - 487 oil
NE NE SW NE #4 426 - 434" - 473"
NW NW SW NE #5 436 - 443" - 466"
NE NE SE NW #6 426 429" - 435" 436 shale - 452 oil
SW NE SW NE #7 363, 370" 404"
approx NW SW NE #8 376 385" 416"

M. J. Kerr	E. A. Kerr
D. A. Lee	

E. A. Kerr Wells
N/2-NE 14-21-22

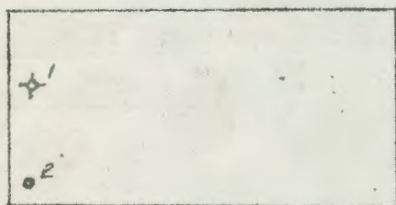


Relative locations

SAND RECORDS

NW NW NE #1 411 - 451
SW NW NE #2 440 - 485

Martha J. Kerr Wells
N/2-NW/4 14-21-22

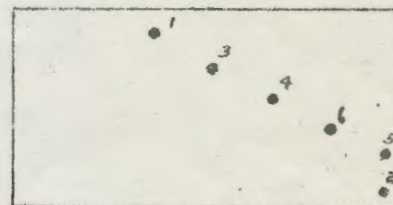

Relative locations

SAND RECORDS

NW NW NE NW #1 453 - 471 gas - 503 oil
SE SE NW NE NW #2 411 - 425 gas 429 sh. - 466
C NE NW #3 440 - 448 bkn. - 469 gas - 472
CS/2 NE NW #4 440 - 455 gas - 477 oil