

Section 22 Township 21 Range 10EWell No. 1 R. C. HaleCompany Don Jones, et al

NORTH

|  |  |  |  |   |  |  |  |
|--|--|--|--|---|--|--|--|
|  |  |  |  |   |  |  |  |
|  |  |  |  |   |  |  |  |
|  |  |  |  |   |  |  |  |
|  |  |  |  |   |  |  |  |
|  |  |  |  | 0 |  |  |  |
|  |  |  |  |   |  |  |  |
|  |  |  |  |   |  |  |  |
|  |  |  |  |   |  |  |  |

WEST

EAST

SOUTH

| Lyon |      | KANSAS |
|------|------|--------|
| SEC. | TWP. | R.     |
| 22   | 21   | 10E    |

WELL NO. 1 R. C. Hale FARM

COMPANY Don Jones et al

CONTRACTOR Berentz

Wildcat


\_\_\_\_\_ Ft. from N. Line

\_\_\_\_\_ Ft. from S. Line

\_\_\_\_\_ Ft. from E. Line

\_\_\_\_\_ Ft. from W. Line

SW SW NE

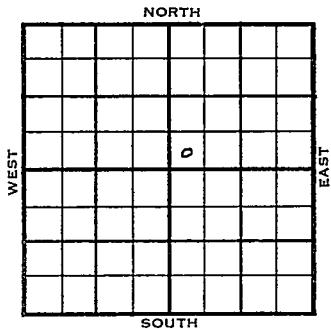

|      | ELEVATION | REPORT |
|------|-----------|--------|
| 1955 | 1250'     |        |

6/29 Location

7/13 D & A  
Bart. 2040', Burg. 2157',  
Miss 2165'  
TD 2195'

**ABANDONED**

County Lyon Elev. \_\_\_\_\_  
 Sec. 22 Twp. 21 Rge. 10E  
 Company Don Jones, et al.  
 Farm Name R. C. Hale No. 1

| TOPS   | DEPTH | LOG | DATUM |
|--------|-------|-----|-------|
| Anh.   |       |     |       |
| T.P.   |       |     |       |
| H.     |       |     |       |
| Tr.    |       |     |       |
| Dg.    |       |     |       |
| BL.    |       |     |       |
| L.     |       |     |       |
| K.C.   |       |     |       |
| B.K.C. |       |     |       |
| Ce.    |       |     |       |
| C.     |       |     |       |
| M.     |       |     |       |
| M.     |       |     |       |
| K.     |       |     |       |
| Mz.    |       |     |       |
| Me.    |       |     |       |
| V.     |       |     |       |
| S.     |       |     |       |
| S.     |       |     |       |
| A.     |       |     |       |
| R.     |       |     |       |
| PE.    |       |     |       |
| G.     |       |     |       |
| T.D.   |       |     |       |

Loc. in Sec. \_\_\_\_\_

SW SW NE

Geol. \_\_\_\_\_

Contr. \_\_\_\_\_

Berentz

Pool \_\_\_\_\_

Wildcat

FIRST REPORT  
 JUN 29 '55

Date Comm. \_\_\_\_\_

Location \_\_\_\_\_

Co.

Lse.

No.

Sec.

T.

R.

County Lyon Elev. 1250 Co.  
 Sec. 22 Twp. 21 Rge. 10E  
 Company Don Jones, et al.  
 Farm Name R. C. Hale No. 1

| TOPS           | DEPTH       | LOG | DATUM      | Loc. in Sec.   |
|----------------|-------------|-----|------------|----------------|
| Anh.           |             |     |            | SW SW NE       |
| Tr.            |             |     |            |                |
| H.             |             |     |            |                |
| Tr.            |             |     |            |                |
| Dg.            |             |     |            |                |
| Bl.            |             |     |            |                |
| L.             |             |     |            |                |
| K.C.           |             |     |            | Geol.          |
| B.K.C.         |             |     |            | Contr.         |
| Ce.            |             |     |            |                |
| C. <u>Bark</u> | <u>2040</u> |     | <u>790</u> | <u>Berenta</u> |
| M. <u>Burg</u> | <u>2157</u> |     | <u>907</u> |                |
| M. <u>iso</u>  | <u>2165</u> |     | <u>915</u> | Pool           |
| K.             |             |     |            | <u>Wildcat</u> |
| Mz.            |             |     |            |                |
| Mq.            |             |     |            |                |
| V.             |             |     |            |                |
| S.             |             |     |            |                |
| S.             |             |     |            |                |
| A.             |             |     |            |                |
| R.             |             |     |            |                |
| PE.            |             |     |            |                |
| G.             |             |     |            |                |
| TD.            | <u>2195</u> |     |            |                |

Date Comm. JUL 13 1955 No. 1

D & A

Sec.

T.

R.