
Form 51 -5M—7-22 9573

Map No. _____ Sec. 22 Twp. 21 R. 12

Well No. 1 Huntsinghouser Farm

Johnson Bdal Company

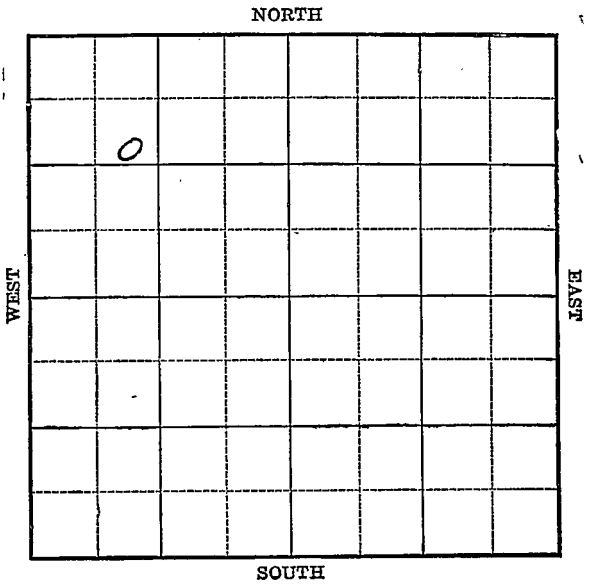

Location _____

Drilling Remarks:

Rig up _____

Drilling Remarks:

RECORD

Cased _____ in. _____ ft.

Sand _____

Gas _____

Oil _____

Total Depth _____

PRODUCTION

1st 24 hrs Nat. _____

1st 24 hrs. after shot _____

Gas _____ cu. ft.

Dry Hole _____

Abandoned _____

Form 252A 5M 8-21 PALACE-TULSA 6835

Map No. _____ Sec. 22 Twp. 21 R. 12

Well No. 1 Huntsinghouser Farm


Johnson Brad Company

1120 Ft. from N, Line

_____ Ft. from S. Line

_____ Ft. from E. Line

1120 Ft. from W. Line

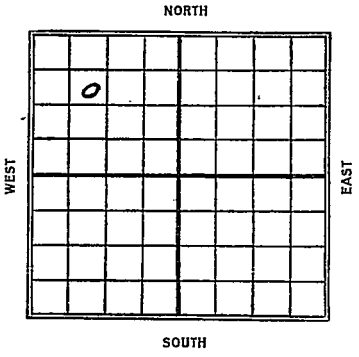

Date	REPORT
1923	
3/2	S.D. 675'
6/23	D+C. 2044'

M—4-19—Mid-West

Map No. KANSAS 21 Sec. 22 Twp. 21 R. 12

Well No. 1 Hunting-Bowers

Johnson Stal Company

Contractor

FIRST REPORT


1120 Ft. from N. Line

Ft. from S. Line

Ft. from E. Line

1120 Ft. from W. Line

SECTION PLAT

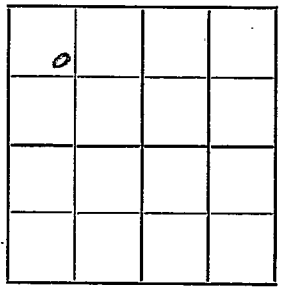

Location

Rig up

Drilling and Remarks:

A.D. 675

RECORD

Cased in., ft.

Sand

Gas

Oil

Total Depth

PRODUCTION

1st 24 hrs. Nat.

1st 24 hrs. after shot

Gas Cu. Ft.

Dry Hole

Abandoned

Date

MAR 2 1923

191

M. A. BENEAR

Scout

Form 26—1M Bks.—3-23—11959.

Map No. KANSAS 71 Sec. 22 Twp. 21 R. 12


Well No. 1 - Hurtsong Brewer

Johnson Mtl Company

Contractor

ABANDONED

SECTION PLAT

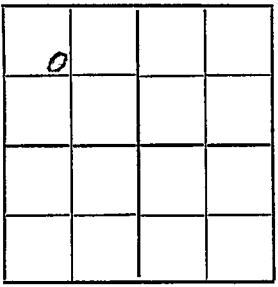

1120 Ft. from N. Line

Ft. from S. Line

Ft. from E. Line

1120 Ft. from W. Line

Location

Rig up

Drilling and Remarks:

40 x 9

2044'

RECORD

Cased in., ft.

Sand

Gas

Oil

Total Depth

PRODUCTION

1st 24 hrs. Nat.

1st 24 hrs. after shot

Gas Cu. Ft.

Dry Hole

Abandoned

Date

JUN 23 1923

192

M. A. BENEAR Scout