


KANSAS

Lyon

Section 23 Township 21 Range 10-E

Well No. #1 Babinger

Company John McNabb et al

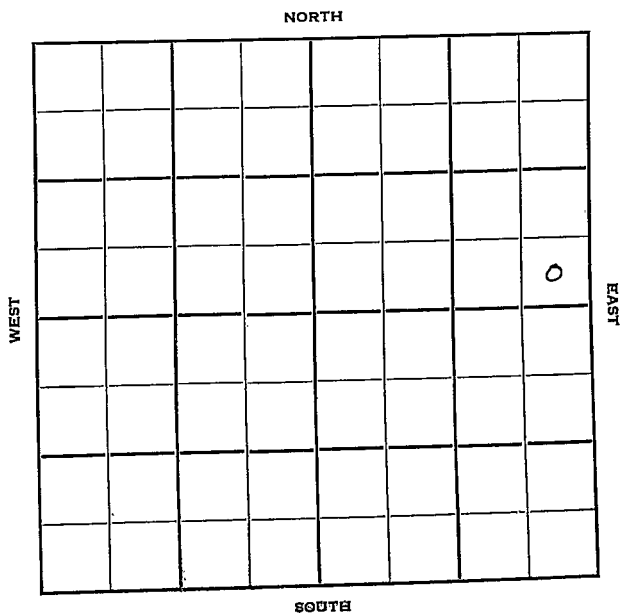

Lyon

KANSAS

Sec. 23 Twp. 21 R. 10E

Well No. #1 Babinger Farm

John McKnabb et al Company

Contractor

Ft. from N. Line

330'


Ft. from S. Line

330'

Ft. from E. Line

Ft. from W. Line

SE SE NE

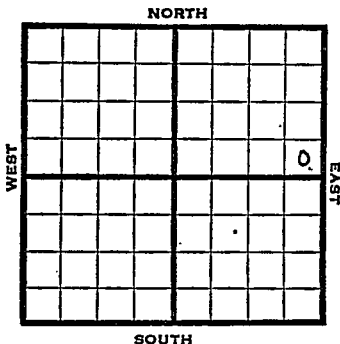

1950 Elev. 1272' REPORT

7/5

Lans. 1133'
KC 1311-1559'
Miss 2152'
Drlg. 2155'

8/2

Lans 1133 KC 1311-1559
Miss 2152 Viola 2584-86
5" @ 2574
Kinderhook 2490
TD 2588 FU 700' Salty wtr
DD 2599
FU 700' fluid 100' oil 10 qt 2580-90
TD 2607 PB 2597 9 qt 2585-97
D&A

ABANDONED

Kansas

Map No. _____ Sec. 23 Twp. 21 R. 10E

Well No. 1 Babinger

John McNabb et al. Company

Contractor

SE SE NE

E. 1272
SECTION PLAT

_____ Ft. from N. Line

330 Ft. from S. Line

330 Ft. from E. Line

_____ Ft. from W. Line



Lyon County

Location _____

Rig up _____

Drilling and Remarks:

Lans. 1133

KC 1311-1559

Miss. 2152

wrlg. 2155

RECORD

Cased _____ in., _____ ft.

Sand _____

Gas _____

Oil _____

Total Depth _____

PRODUCTION

1st 24 hrs. Nat. _____

1st 24 hrs. after shot _____

Gas _____ Cu. Ft.

Dry Hole _____


Abandoned _____

Date

JUL 5 1950 19

J. E. TYRA Scout

County Lyon State Kansas
 Sec. 23 (Bk. 21 (Sur. 10E Map No.
 (Twp. (Rge.)
 Operator John McNabb et al.
 Well No. 1 Farm Babinger
 Elev. 1272 Location SE SE NE

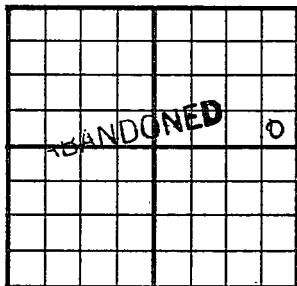

330 Ft. From S Line NE
330 Ft. From E Line Quarter

1st. Report

Completion AUG 2 1950

Remarks

Spudding Date

Drlg. Data

Lans. 1133 KC 1311-1559 Miss. 2152

Viola 2584-86 5" @ 2574 Kinderhook 2490

TD 2588 FU 700' salty water DD 2599

FU 700' fluid 100' oil 10 qt. 2580-90

TD 2607 PB 2597 9 qt/ 2585-97

D & A'

J. E. TYRA