FORM 51 10M 7-48 PETROL

Chase


KANSAS

Section 24 Township 21 Range 9E

Well No. 2 Hughs

Company Sheedy Et al

Misc.

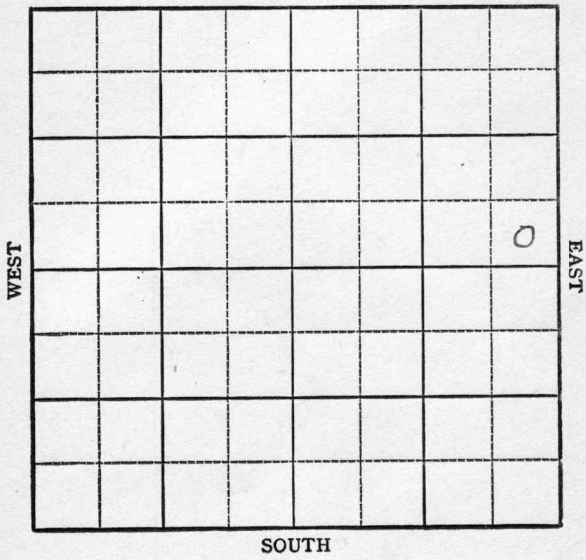

FORM 252-A
5M 4-48 PETROL


KANSAS Chase

Sec. 24 Twp. 21 R. 9E

Well No. 2 Hughs Farm

Sheedy et al Company

Misc.

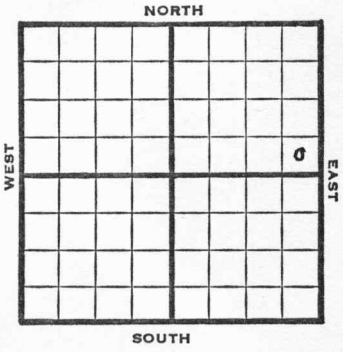

_____ Ft. from N. Line

330 Ft. from S. Line

330 Ft. from E. Line

_____ Ft. from W. Line

SE NE

1948	Elev. - REPORT
9/22	6" @ 2170'
9/29	Bart 2228' Miss 2352' TD 2355' ABANDONED

Form 27—100 Bks.—4-48—Petrol

Chase County Kansas State

Map No. Sec. 24 Twp. 21 R. 9E


Well No. 2 Hughs

Sheedy etal. Company

FIRST REPORT Contractor

SE NE

SECTION PLAT

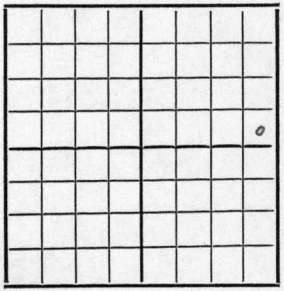

Ft. from N. Line

330 Ft. from S. Line

330 Ft. from E. Line

Ft. from W. Line

Miscellaneous

Remarks:

6" @ 2170

Date SEP 2 2 1948

Scout S. J. LEWIS

Form 26—200 Bks.—1-48—Palace

Kansas

Miscellaneous

Map No. 22 Sec. 24 Twp. 21 R. 9E


Well No. 2 Hughs

Sheedy etal. Company

ABANDONED Contractor

SE NE

SECTION PLAT

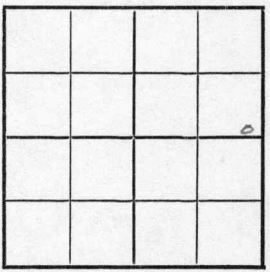

____ Ft. from N. Line

330 Ft. from S. Line

330 Ft. from E. Line

____ Ft. from W. Line

Chase County

Location

Rig up

Drilling and Remarks:

Bar 2225

Miss 2352

RECORD

Cased ____ in., ____ ft.

Sand

Gas

Oil

Total Depth 2355

PRODUCTION

1st 24 hrs. Nat.

1st 24 hrs. after shot

Gas ____ Cu. Ft.

Dry Hole

Abandoned

Date

SEP 29 1948 19____ S. J. LEWIS Scout

Twp. X Pool Drilling

Co. X Pool

O.W.W.O.

S-513-B

County Chase Elev.

Sec. 24 Twp. 21 Rge. 9E

Company A. W. Throckmorton

Farm Name Hughes No. 8

TOPS	DEPTH	LOG	DATUM
Anh.			
Tp.			
H.			
Tr.			
Dg.			
B. L.			
L.			
K.C.			
B.K.C.			
Ce.			
~~α~~ Btvl	2228		
M.	2319½		
M.			
K.			
Mz.			
Mq.			
V.			
S.			
S.			
A.			
R.			
Pf.			
G.			
OTD	2355		
T.D.			

Loc. in Sec. SE SE NE

(O.W.W.O.)

Geol. O.W.W.O.

Contr. Eureka Drlg.

Pool Pixlee

JUL 15 58

FIRST REPORT

COMPLETE

Date Comm. 5-8-58

OLD INFO: Tops. D & A.

NEW INFO: Btvl 2234, 4" @ 2340, CO 2340, 2s/2238-44 frac 20,000 Sd 300 BW 400 BO POP P 10 BOPD no wtr COMPLETE

Co. Lse. No. Sec. T. R.