


Section 24 Township 21 Range 1E

Well No. #1 Voth

Company Time Petroleum

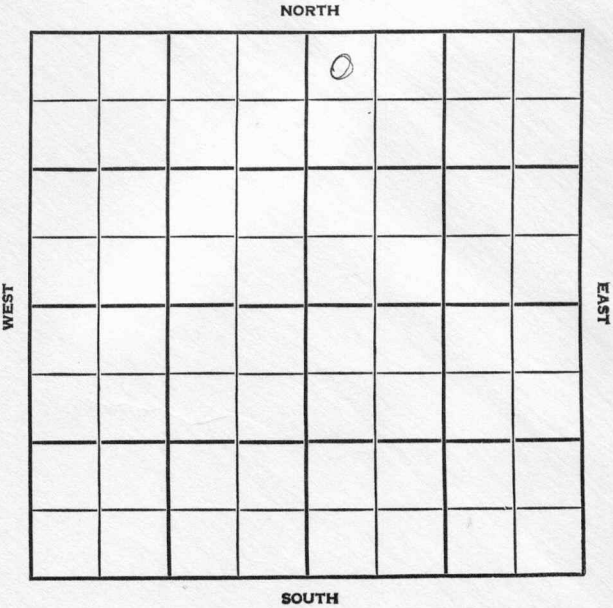

WILDCAT

County Marion Elev. _____
 Sec. 24 Twp. 21 Rge. 1E
 Company Time Petroleum
 Farm Name Voth No. 1

TOPS	DEPTH	LOG	DATUM	Loc. in Sec.
Anh.				NW NW NE
Tp.				
H.				
Tr.				
Dg.				
Bl.				
L.				Geol.
K.C.				Contr.
B.K.C.				Kirkpatrick
Ce.				Tools
C.				Pool
M.				Wildcat
M.				
K.				
Mz.				
Mq.				
V.				
S.				
S.				
A.				
R.				
Pe.				
G.				
T.D.				

FIRST REPORT

OCT 31 '66

Date Comm.

C & P

NOV 2 1966

D. A.

County Marion Elev. 1556
 Sec. 24 Twp. 21 Rge. 1E
 Company Time Petroleum
 Farm Name Voth No. 1

TOPS	DEPTH	LOG	DATUM	Loc. in Sec.
Anh.				NW NW NE
Tr.				
H.				
Tr.				
Dg. <u>sd</u>	<u>2040</u>			
Bl.				
L.	<u>2294</u>			Geol.
K.C.				Contr.
B.K.C.	<u>2584</u>			
Ce.				
C. <u>Burg</u>	<u>2903</u>			Kirkpatrick
M.	<u>2918</u>			Tools
M.				Pool
K. <u>sh</u>	<u>3129</u>			
Mz.	<u>3269</u>			Wildcat
Me.				
V. <u>HUNT</u>	<u>3272</u>			
S. <u>sh</u>	<u>3299</u>			
S. <u>V10</u>	<u>3354</u>			
A. <u>SP Dolo</u>	<u>3390</u>			
R. <u>" sd</u>	<u>3401</u>			
PE.				
G.				
T.D.	<u>3418</u>			

ABANDONED
NOV 15 '56

Date Comm.

C & P NOV 7 '56 10-31-56 85/8

115 ID 2200 NOV 13 '56 DST 3264

-74 in 1 in rec 8' Md FP 35-35

1050 115" DST 3269-79 1 in

rec 20' Md BHP 1015

D&A