

Marion

KANSAS

SECTION 24 TOWNSHIP 21 RANGE 2E

WELL NO. #1 Ezra Eitzen

COMPANY Chas. S. Ritchie

NORTH

WEST	0							

EAST

SOUTH


SEC.	24	TWP.	21	R.	2E
------	----	------	----	----	----

WELL NO. #1 Ezra Eitzen FARM

COMPANY Chas S. Ritchie

CONTRACTOR White & Ellis Tools

\_\_\_\_\_ FT. FROM N. LINE  
 \_\_\_\_\_ FT. FROM S. LINE  
 \_\_\_\_\_ FT. FROM E. LINE  
 \_\_\_\_\_ FT. FROM W. LINE

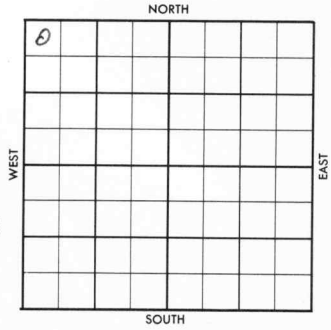

NW NW NW

1956 ELEVATION REPORT

9-5  
 Comm 8-30-56  
 8" @ 124 w/90  
 Twist off @ 2504,  
 Drlg ahead

**ABANDONED**



County Marion Elev. 1452  
 Sec. 24 Twp. 21 Rgs. 2E  
 Company Chas. S. Ritchie  
 Farm Name Ezra Litzen No. 1

TOPS	DEPTH	LOG	DATUM	Loc. in Sec.
Anb.				NW NW NW
TP.				
H.				
Tr.				
Dg.				
Bl.				
L.	2085	2087		Geol.
K.C.	2295	2218		Concr.
B.K.C.		2456		
Ce.				
G. <u>M. chert</u>		2708		White & Elli
M.	2842	2844		Tools
M. <u>Base</u>		2893		Pool
K.				
Mz.	3041			
Me. <u>Hunt</u>	3047	3039		
V.	3097	3101		
S.		3121		
S.				
A.				
R.				
Pe.				
G.				
TD.	3125			

SEP 12 '56

ABANDONED

Date Comm. 8/30/56  
8" x 124 w/90, twist off @ 2504, Erg. ahead

SEP 12 '56

D&A.

Co.  
 Sec.  
 No.  
 Sec.  
 T.  
 R.