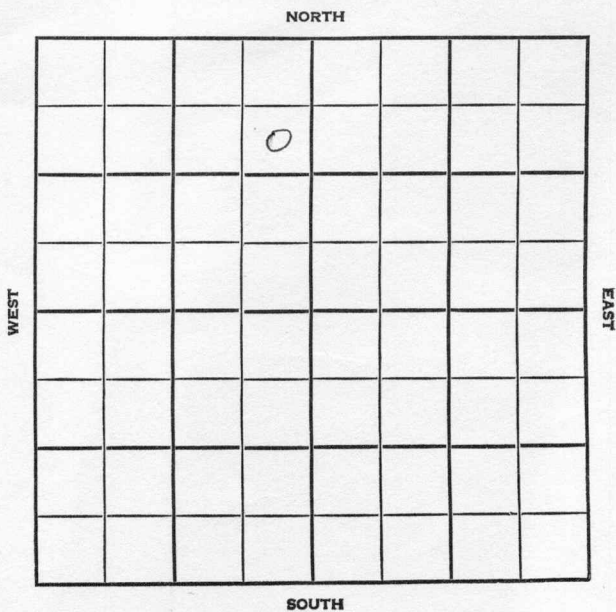


Section 24 Township 21 Range 10EWell No. #5 Babinger "C"Company WHITE & ELLIS

Lyon

KANSAS

SEC.

TWP.

R.

24

21

10E

WELL NO.

#5 Babinger "C"

FARM

COMPANY

White & Ellis

CONTRACTOR

Co. tools


Bradfield

_____ FT. FROM N. LINE

_____ FT. FROM S. LINE

_____ FT. FROM E. LINE

_____ FT. FROM W. LINE

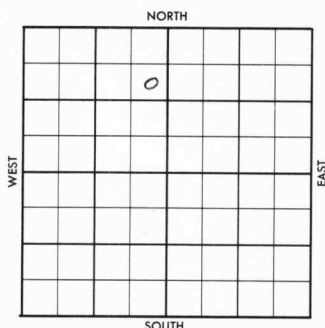

SE NE NW

1956

ELEVATION

REPORT

6-27

Comm. 6-22-56

8" @ 104/75

drlg. 2000

7-25

5½" @ 2502 w/75

DD 2511

P/ 25 BOPD / trace wtr.

L. 1045'; KC. 1209'; M. 2080';

Mz. 2495'; V. 2496';

TD 2504'

COMPLETED

No County Map

County Lyon Elev. _____Sec. 24 Twp. 21 Rgs. 10ECompany White & EllisFarm Name Babinger "C" No. 5

TOPS

DEPTH

LOG

DATUM

Loc. in Sec. _____

Anh.

Tp.

H.

Tr.

Dg.

BL.

L.

K.C.

B.K.C.

Ce.

C.

M.

M.

K.

Mz.

Mq.

V.

S.

S.

A.

R.

Pe.

G.

T.D.

SE NE NW

Geol. _____

Contr. _____

Co. tools

Pool

Bradfield

FIRST REPORT

JUN 27 '56

Date Comm. 6-22-568" @ 104/75 drlg. 2000

422

No County Map

County Ivon Elev. _____
 Sec. 24 Twp. 21 Rgs. 10E
 Company White & Ellis
 Farm Name Babiner "C" No. 5

TOPS	DEPTH	LOG	DATUM	Loc. in Sec.
Anh.				SE NE NW
TP.				
H.				
Tr.				
Dg.				
Bl.				
L.	1045			Geol.
K.C.	1209			Contr.
B.K.C.				Co. tools
Ce.				Pool
C.	2080			Bradfield
M.				
M.				
K.				
Mz.	2495			
Me.				
V.	2496			
S.				
S.				
A.				
R.				
Pe.				
G.				
TD.	2504			

COMPLETE

JUL 25 1956

Date Comm.

6-22-56

8" @ 104/75 drls. 2000 JUL 3 '56

5 1/2 @ 2502/75 WOC JUL 11 '56 CO

JUL 18 '56

JUL 25 '56

DD 2511 1/2

Pop. P. 25 Bopd + Trace
wt.