


Section 24 Township 21 Range 10 E

Well No. # 1 Perrier "A"

Company White & Ellis

NORTH

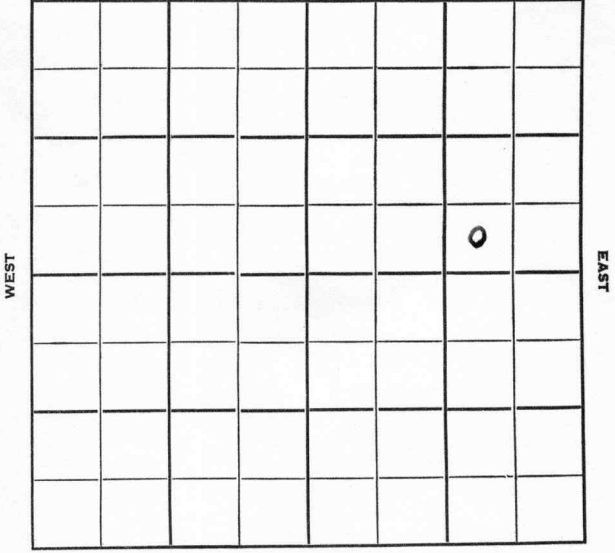

SOUTH

WEST

EAST



Sec. 24 Twp. 21 R. 10 E

Well No. # 1 Perrier "A" Farm

White & Ellis Company

White & Ellis Contractor

Bradfield Pool


Ft. from N. Line

330 Ft. from S. Line

990 Ft. from E. Line

Ft. from W. Line

SW SE NE

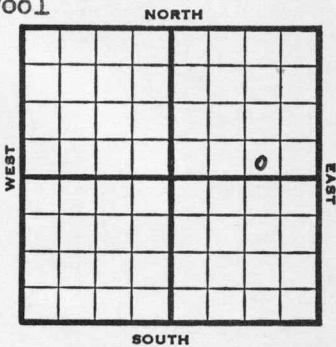

1953

Elev. -

REPORT

~~6/10~~  
6/17

Spud 6-12-53  
8" @ 110 Lans 1044  
Drlg. 1094'

7/15

Spud 6-12-53  
Oil Well  
TD 2504  
8" @ 110  
Lans 1044, KC 1207, Miss 2058, Viola  
2499  
TD 2502  
5" @ 2500  
DD 2504, 500A  
Comp. 25 bopd 24 bw

COMPLETED



