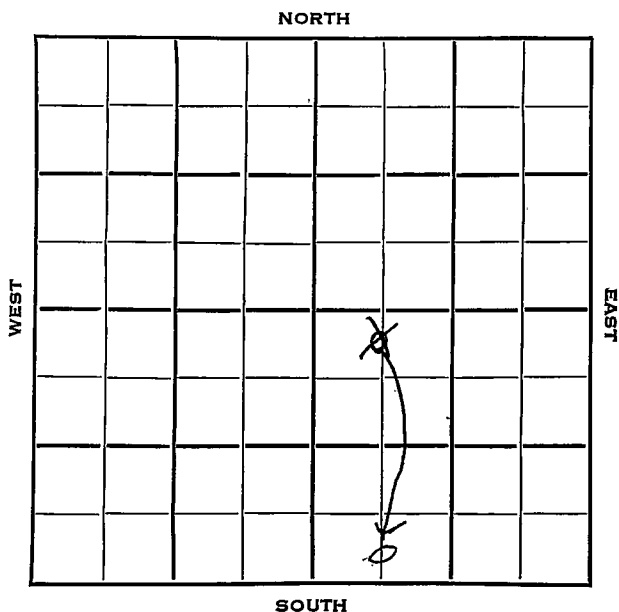


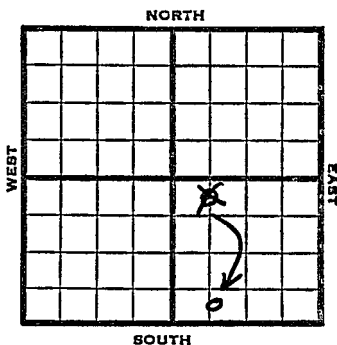
Section 24 Township 21 Range 10 EWell No. # 2 RossillionCompany R. J. Wixon

KANSAS

Lyon

Sec. 24 Twp. 21 R. 10EWell No. #2 Rossillion FarmR. J. Wixon CompanyWixon ContractorBradfield Pool330 Ft. from N. Line330 Ft. from S. Line

Ft. from E. Line

700
660 Ft. from W. Line~~C N L NW SE~~
App. C S $\frac{1}{2}$ SW SE

1953

Elev. -

REPORT

7/1

Spud 6-26-53
drlg. 200'

9/2

Spud 6-26-53
Oil Well

TD 2609'

13" @ 1119'

Lans 1138'

10" @ 1550'

Miss 2160'

8" @ 2175'

Viola 2597'

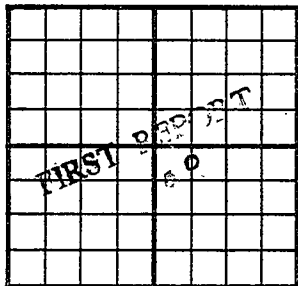
7" @ 2605'

DD 2609 FU 2000' oil 500 A

PB 2607'

Comp. 25 bopd 5 bw.

COMPLETED

County Lyön State KansasSec. 24 (Blk. Twp.) 21 (Sur. Rge.) 10E Map No.Operator R. J. WixonWell No. -2 Farm RossillionElev. Location C / L NW SE330 Ft. From N Line SE600 Ft. From W Line Quarter1st. Report Jul 1 1953

Completion

Remarks

Wixon - Contr.Spudding Date 6-26-53Drlg. Data Bradfield Pooldrlg. 200

Lyon

Kansas

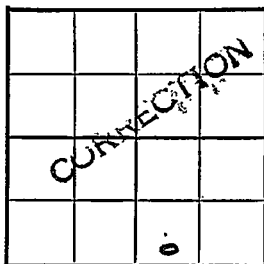
Map No. _____ Sec. 24 Twp. 21 R. 10EWell No. 2 RossillionR. J. Wixson

Company

Contractor

App C S/2 SW SE

SECTION PLAT



_____ Ft. from N. Line

330 Ft. from S. Line

_____ Ft. from E. Line

700 Ft. from W. Line

Location _____

Rig up _____

(Drilling and Remarks:

Reported

C N/2 NW SE

RECORD

Cased _____ in., _____ ft.

Sand _____

Gas _____

Oil _____

Total Depth _____

PRODUCTION

1st 24 hrs. Nat. _____

1st 24 hrs. after shot _____

Gas _____ Cu. Ft.

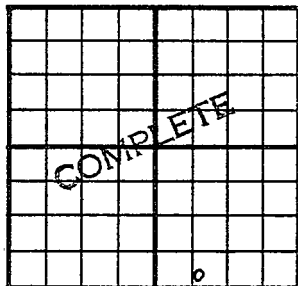
Dry Hole _____

Abandoned _____

Date
JUL 8 1953**J. G. McGEHEE**

19

Scout

County Lyon State KansasSec. 24 (Blk.
Twps.) 21 (Sur.
Rgs.) 10E Map No.Operator R. J. WixonWell No. 2 Farm RossillionElev. Location C S L SW SE300 Ft. From S Line SE750 Ft. From W Line Quarter1st. ReportCompletion SEP 2 1953Remarks Bradfield PoolWixon - Contr.Spudding Date 6-26-53Drig. Data Oil well TD 260913" @ 1119 Lans. 1138 10" @ 1550Miss. 2160 8" @ 2175 Viola 25977" @ 2605 DD 2609 FU 2000' oil 500 APB 2607 Comp. 25 bopd 5 bw