


Lyon KANSAS

DX 78-1

Section 24 Township 21 Range 10E ✓

Well No. 5 Rossilion

Company Wixson

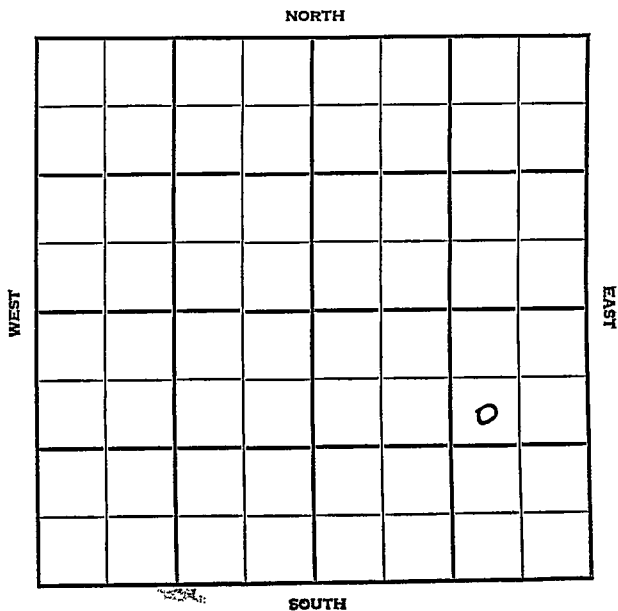

Lyon KANSAS

SEC.	TWP.	R.
24	21	10E

WELL NO. **5 Rossilion** FARM

COMPANY **Wixson**

CONTRACTOR **Wixson**


Bradfield Pool

990 _____ Ft. from N. Line

_____ Ft. from S. Line

990 _____ Ft. from E. Line

_____ Ft. from W. Line

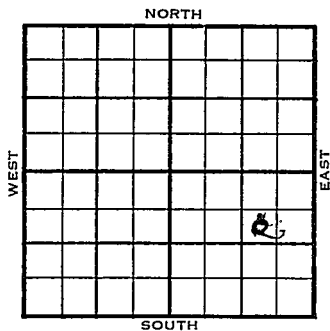

SW NE SE

1954	ELEVATION	REPORT

~~7/14~~
~~xxxx~~

Spdg 7-11-54
drlg.

8/25

Spud 7-11-54 Oil well TD 2516
10" @ 1588 Miss 2075 8" @ 2076
Lans. 1036 KC 1320 Misener 2510
TD 2513 5" @ 2513 GO to 2516
S/20 BOPD Comp. 20 BOPD

COMPLETED

