


Section 24 Township 21 Range 10E

Well No. #1-A Babinger

Company White & Ellis

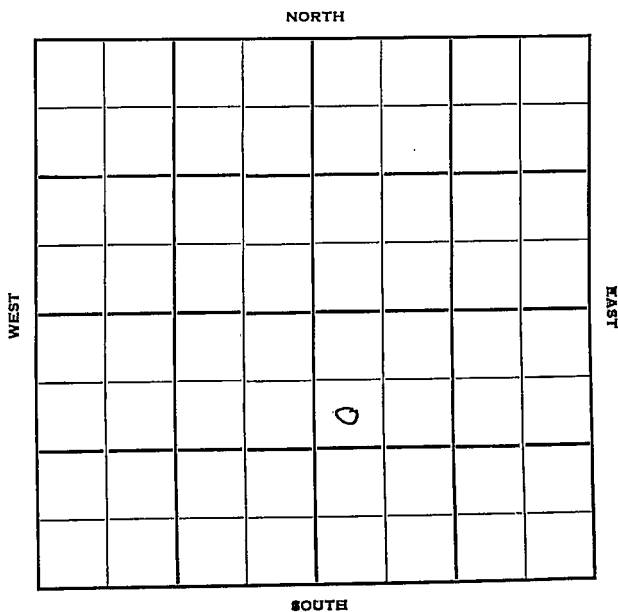

Lyon

KANSAS

Sec. 24 Twp. 21 R. 10E

Well No. #1-A Babinger Farm

White & Ellis Company

IF Contractor


990 Ft. from N. Line

_____ Ft. from S. Line

_____ Ft. from E. Line

330 Ft. from W. Line

SW NW SE (TWIN WELL)

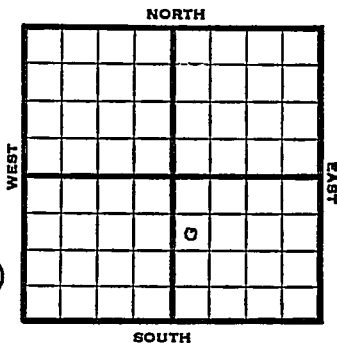

1952

Elev. - REPORT

10/15

Location

12/30

Spud 10-19-52

D & A TD 1519' 10" @ 110

KC 1387' TD 1506' 7" @ 1505

DE 1519' 500 A PB 1514' 500 A

D & A

ABANDONED

