


Lyon

KANSAS

Section 24 Township 21 Range 10E

Well No. #5 Babinger "A"

Company White & Ellis

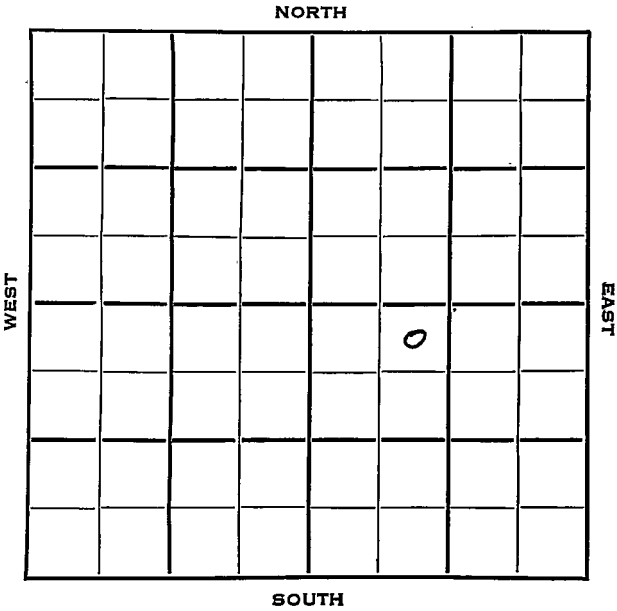

Lyon

KANSAS ✓


Sec. 24 Twp. 21 R. 10EWell No. #5 Babinger "A" FarmWhite & Ellis CompanyWhite & Ellis ContractorBradfield Pool330 Ft. from N. Line

Ft. from S. Line

Ft. from E. Line

990 Ft. from W. Line

NE NW SE

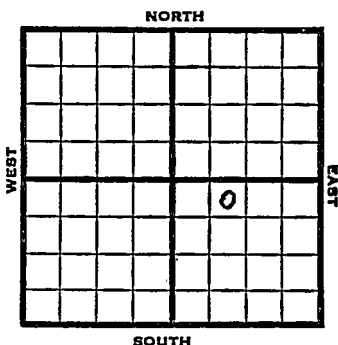

1953

Elev. -

REPORT

7/29

Spud 7-27-53

9/2

Spud 7-27-53

Oil Well

TD 2515'

8" @ 55'

KC 1218', Miss 2067', Viola 2507'

TD 2513'

5" @ 2512'

CO to 2513'

10 A $1\frac{1}{2}$ gw SSO 1 hr.

20 A DD 2515 FU 2300' oil 3 hr.

Comp. 25 bopd.

COMPLETED

County **Lyon** State **Kansas**

Sec. **24** (Blk. **21** (Sur. **10E** Map No.

Operator **White & Ellis**

Well No. 5 Farm Babinger "A"

Elev.	Location	NE	NW	SE
-------	----------	----	----	----

FIRST REPORT

330 Ft. From N Line SE

990 Ft. From ~~TV~~ Line Quarter

1st. Report **JUL 29 1953**

Completion _____

Remarks

White & Ellis - Contr.

Spudding Date **7-27-53**

Drbg. Data

J. G. McGEHEE

Elev.	Location	NE	NW	SE
-------	----------	----	----	----

[illegible]

330Ft. From N Line SE

990Ft. From W Line Quarter

1st. Report

Completion SEP 2 1953

Remarks	Bradfield Pool
---------	----------------

White & Ellis - Contr.

Spudding Date 7-27-53

Drilg. Data Oil well TD 2515

8th @ 55 KC 1218 Miss. 2067

Viola 2507 TD 2513 5" @ 2512

CO to 2513 10 A $1\frac{1}{2}$ gw SSO 1 hr.

20 A DD 2515 ETU 2300' oil 3 hr.

Comp. 25 bopd

J. G. McGEHEE