

Chase


KANSAS

SECTION 24 TOWNSHIP 21 RANGE 9E

WELL NO. #3 Hughes

COMPANY Sauder, Throgmorton & French

NORTH

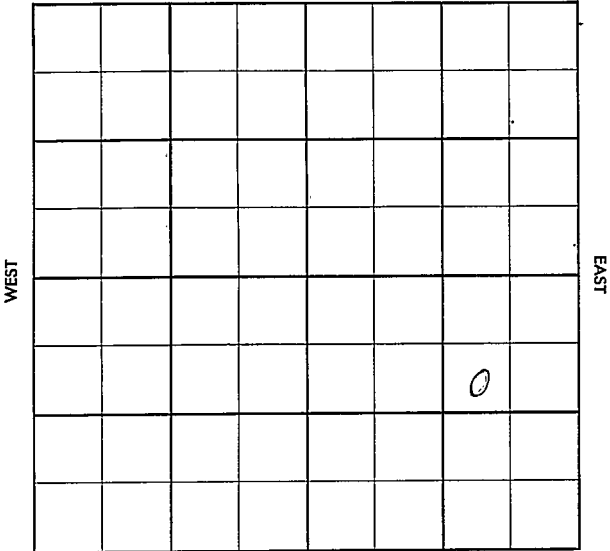

SOUTH

County Chase Elev. _____
 Sec. 21 Twp. 21 Rgs. 9E
 Company Sauder, Throgmorton & French
 Farm Name Hughes No. 3

TOPS	DEPTH	LOG	DATUM	Loc. in Sec.
Anb.				SW NE SE
TP.				
H.				
Tr.				
Dg.				
BL.				
L.				Geol.
K.C.				Contr.
B.K.C.				Sauder
Ce.				
C.				Pool
M.				Ateyo-Pixlee
M.				
K.				
Mz.				
Me.				
V.				
S.				
S.				
A.				
R.				
PE.				
G.				
T.D.				

FIRST REPORT

JAN 3 '57

Date Comm.

drlg.

County Chase Elev. _____
 Sec. 21 Twp. 21 Rge. 9E
 Company Sauder, Throgmorton & French
 FarmName Hughes No. 3

TOPS	DEPTH	LOG	DATUM	Loc. in Sec.
Anh.				SW NE SE
Tr.				
H.				
Tr.				
Dg.				
BL.				
L.				Geol.
K.C.				Contr.
B.K.C.				Sauder
Ce.				
C.				Pool
M. <u>chert</u>	<u>2300</u>			Atevo-Pixlee
M. <u>LI</u>	<u>2307</u>			
K.				
Mz.				
Me.				
V.				
S.				
A.				
R.				
PE.				
G.				
TD.	<u>2327</u>			

ABANDONED

JAN 16 57

Date Comm.

drlg. JAN 3 57 12-26-56 10' @

1090 8" @ 1591 1675

JAN 7

DEA