

Lyon


KANSAS

FORM 51

Section 24 Township 21 Range 10E

Well No. #6 Babinger "A"

Company White & Ellis

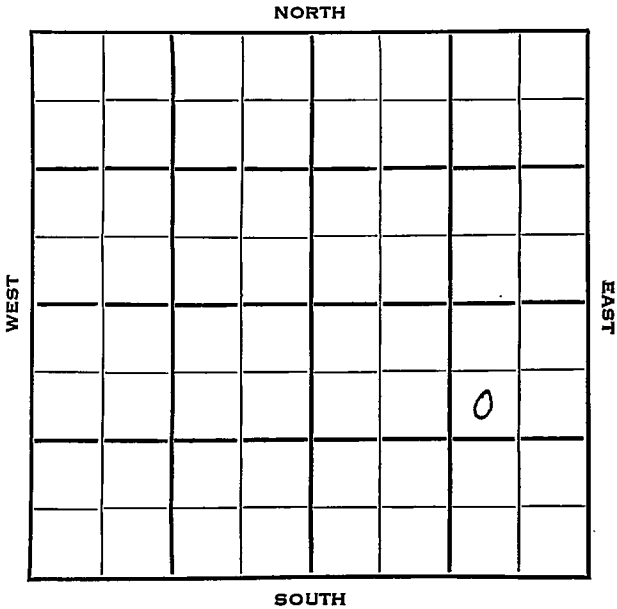

24

21

10E

Sec. _____ Twp. _____ R. _____

Well No. #6 Babinger "A" Farm _____

White & Ellis Company _____

White & Ellis Contractor _____


990 Ft. from N. Line

_____ Ft. from S. Line

990 Ft. from E. Line

_____ Ft. from W. Line

SW NE SE

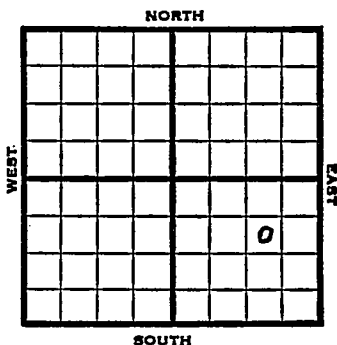

1953

Elev. - REPORT

8/12

RUR

9/2

Spud 8-7-53

Oil Well

TD 2516'

8" @ 110'

Miss 2068, Viola 2514

TD 2516'

5" @ 2516'

CO to 2516

5 mud-acid 25 A B/ 20 go 4 gwph

15 mud-acid fu 160' oil 120' wtr.

4 hr.

Comp. 25 bopd.

COMPLETED

