


Section 24 Township 21 Range 10E

Well No. #2 Babinger "B"

Company White & Ellis

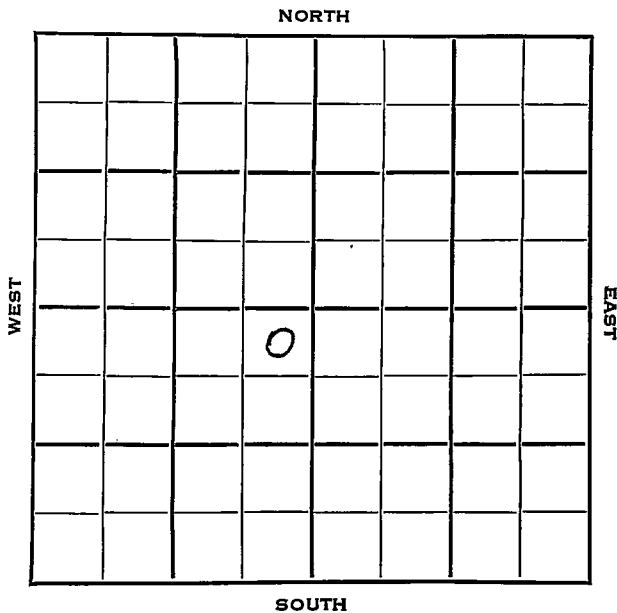

Lyon

KANSAS ✓

Sec. 24 Twp. 21 R. 10E

Well No. #2 Babinger "B" Farm

White & Ellis Company

White & Ellis Contractor


Bradfield Pool NORTH

330 Ft. from N. Line

_____ Ft. from S. Line

330 Ft. from E. Line

_____ Ft. from W. Line

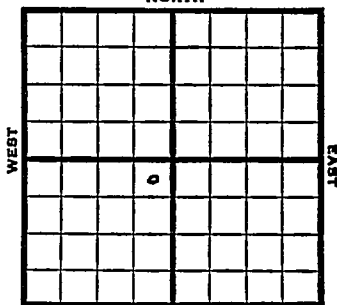

NE NE SW

1953

Elev. -

REPORT

7/22

Spud 7-18-53
Drlg 1245'

9/2

Spud 7-18-53
Oil Well
TD 2566'
8" @ 115'
Miss 2127', Viola 2563
TD 2566'
5" @ 2563'
CO to 2566
15 A S/ 10 go 12 gwph 56 A
Comp 25 bopd.

COMPLETED

County Lyon State Kansas

Sec. 24 (Blk. 21 (Sur. Rge.) 10E Map No.

Operator White & Ellis

Well No. 2 Farm Babinger "B"

Elev. Location NE NE SW

COMPLETE					

330 Ft. From N Line SW

330 Ft. From E Line Quarter

1st. Report

Completion SEP 2 1953

Remarks Bradfield Pool

White & Ellis - Contr.

Spudding Date 7-18-53

Drig. Data Oil well TD 2566

8" @ 115 Miss. 2127 Viola 2563

TD 2566 5" @ 2563 CO to 2566 15 A

S/ 10 go 12 gwph 56 A

Comp. 25 bopd