


Section 24 Township 21 S Range 10 E

Well No. #3 Babinger "B"

Company White & Ellis

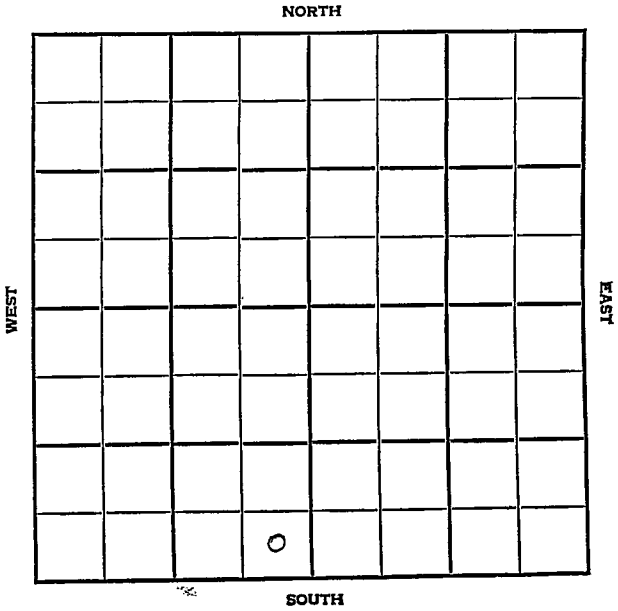

Lyon

KANSAS

SEC. 24	TWP. 21S	R.. 10E
------------	-------------	------------


WELL NO. #3 Babinger "B" FARM

COMPANY White & Ellis

CONTRACTOR Co. Tools

Bradfield

\_\_\_\_\_ Ft. from N. Line  
 \_\_\_\_\_ Ft. from S. Line  
 \_\_\_\_\_ Ft. from E. Line  
 \_\_\_\_\_ Ft. from W. Line

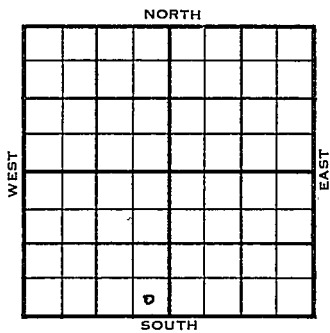

SE SE SW

1955	ELEVATION	REPORT
------	-----------	--------

9/28

Comm 9-21-55  
 8" @ 90 w/75'  
 D 2200

No County

County Iyon Elev.Sec. 21 Twp. 21S Rge. 10ECompany White & EllisFarm Name Babinger "B" No. 3

TOPS	DEPTH	LOG	DATUM
Anh.			
Tr.			
H.			
Tr.			
Dg.			
Bl.			
L.			
K.C.			
B.K.C.			
Ce.			
C.			
M.			
M.			
K.			
Mz.			
Me.			
V.			
S.			
S.			
A			
R.			
Pe.			
G.			
T.P.			

Loc. in Sec.

SE SE SW

Geol.

Contr.

Co. tools

~~Fig #3~~

Pool

Bradfield

FIRST REPORT

Co.

Lse.

No.

Sec.

T.

R.

Date Comm. 9-21-55

SEP 28 1955

8" 90' W/75; D 2200