

Lyon


KANSAS

FORM 51

Section 24 Township 21 Range 10E

Well No. #1 Babinger "C"

Company White & Ellis

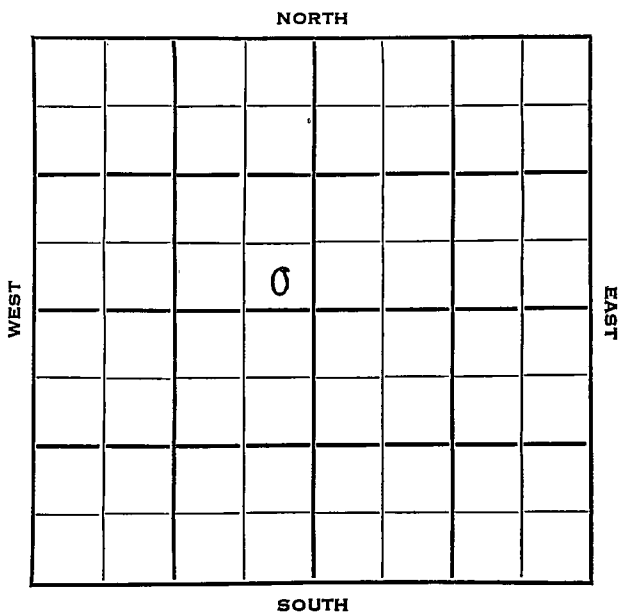

Lyon

KANSAS

Sec. 24 Twp. 21 R. 10E

Well No. #1 Babinger "C" Farm

White & Ellis Company

White & Ellis Contractor

Bradfield Pool


Ft. from N. Line

330 Ft. from S. Line

330 Ft. from E. Line

Ft. from W. Line

SE SE NW

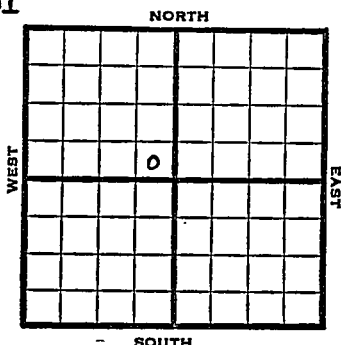

1953

Elev. -

REPORT

4/29

Spud 4-22-53

8" @ 105'

Lans 1045', KC 1209', Miss Ch. 2068',

Drlg. 2075'

6/3

Spud 4-22-53

Oil well TD 2514 8" @ 105'

Lans 1045' KC 1209' Miss ch. 2068'

Viola 2508 TD 2514 5" @ 2511

CO to 2514 500 A

Comp. 25 BOPD 10 BW

COMPLETED

County Lyon State Kansas
 Sec. 24 (Blk. Twp.) 21 (Sur. Rge.) 10E Map No.
 Operator White & Ellis
 Well No. 1 Farm Habinger "C"
 Elev. _____ Location SE SE NW

		0			

FIRST REPORT

330 Ft. From S Line NW
330 Ft. From E Line Quarter
 1st. Report APR 29 1953
 Completion _____
 Remarks _____
White & Ellis - Contr.
 Spudding Date 4-22-53

Drlg. Data Bradfield Pool
8" @ 105 Lans. 1045 KC 1209
Miss. ch. 2068 drlg. 2075

J. G. McGEHEE