


Section 24 Township 21 Range 10E

Well No. 2 Babinger "C"

Company White & Ellis

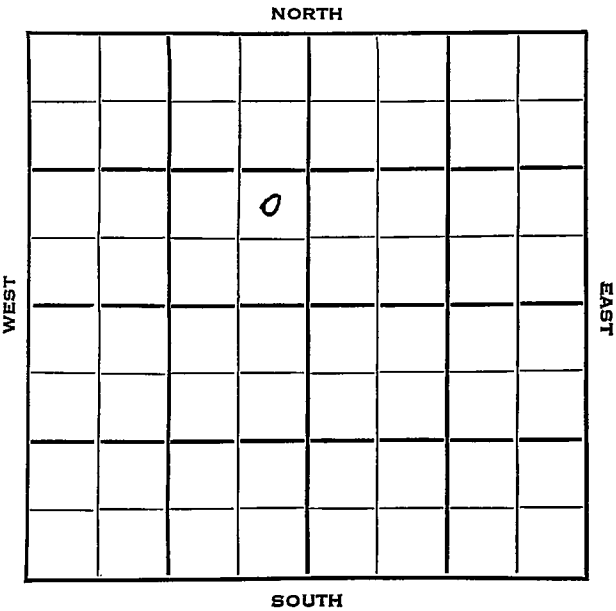

KANSAS

WELL NO.

#2 Babinger "C"

FARM

COMPANY

White & Ellis

CONTRACTOR

White & Ellis


Ft. from N. Line

990 Ft. from S. Line

330 _____ Ft. from E. Line

Ft. from W. Line

NE SE NW

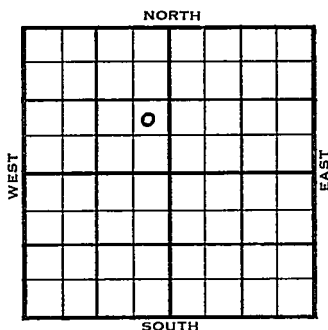

1953	ELEVATION ----	REPORT
11/4	Spud 10-28-53 8" @ 30' Lans 1038', KC 1207' Drlg 2106'	
11/24	Spud 10-28-53 Oil well TD 2505 8" @ 30 Lans 1038 KC 1207 Miss. 2071 Viola 2497 TD 2505 5" @ 2504 CO to 2505 FU 250' oil 4 hr. 500 A Comp. 25 BOPD	
COMPLETED		

J. G. McGEHEE

J. G. McGEHEE