

Lyon

FORM 51

KANSAS

Section 24 Township 21 Range 10E

Well No. #3 Babbinger "C"

Company White & Ellis

NORTH

			0				

WEST

EAST

SOUTH

Lyon KANSAS

SEC.	TWP.	R.
24	21	10E ✓

WELL NO.

3 Babbinger "C"

FARM

COMPANY

White & Ellis

CONTRACTOR

White & Ellis

Bradfield Pool


330 Ft. from N. Line

Ft. from S. Line

330 Ft. from E. Line

Ft. from W. Line

NE NE NW

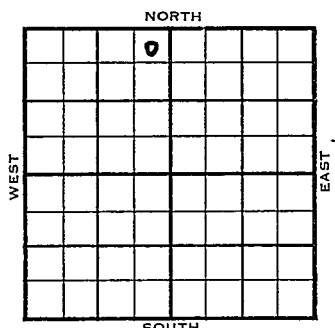

1954

ELEVATION

-

REPORT

4/14

Spud 4-8-54

8" @ 105'

Drlg. 2375'

5/5

Spud 4-8-54

Oil Well

TD 2576'

8" @ 105'

Lans 1062'

KC 1245'

Miss 2091'

Viola 2524'

Arb. 2537'

TD 2576'

5" @ 2576'

CO to 2570

12/2551-52, 50 mud-acid

FU 254' oil 16 hrs.

Comp. 20 bopd 20 bw

COMPLETED

County **Lyon** State **Kansas**Sec. **24** (Blk.) **21** (Sur.) **10E** Map No.Operator **White & Ellis**Well No. **3** Farm **Babbinger "C"**Elev. Location **NE NE NW**

330 Ft. From **N** Line **NW**330 Ft. From **E** Line **Quarter**1st. Report **APR 14 1954**

Completion

Remarks

White & Ellis - Contr.Spudding Date **4-8-54**Drlg. Data **Bradfield Pool****8" @ 105 drlg. 2375**

County Lyon State Kansas
 Sec. 24 (Blk.) 21 (Sur.) 10E Map No.
 Operator White & Ellis
 Well No. 3 Farm Babbinger "C"
 Elev. Location NE NE NW

			0			

330. Ft. From N Line NW
330 Ft. From E Line Quarter
 Ist. Report
 Completion MAY 5 1954
 Remarks Bradfield Pool
White & Ellis - Contr.
 Spudding Date 4-8-54

Drlg. Data Oil well TD 2576
8" @ 105 Lans. 1062 KC 1245
Miss. 2091 Viola 2524 Arb. 2537
TD 2576 5" @ 2576 CO to 2570
12/ 2551-52 50 mud-acid FU 254' oil
16 hr. Comp. 20 bopd 20 bw