


Section 24 Township 21 Range 9E

Well No. #1 Hughes

Company Sauder & Throgmorton

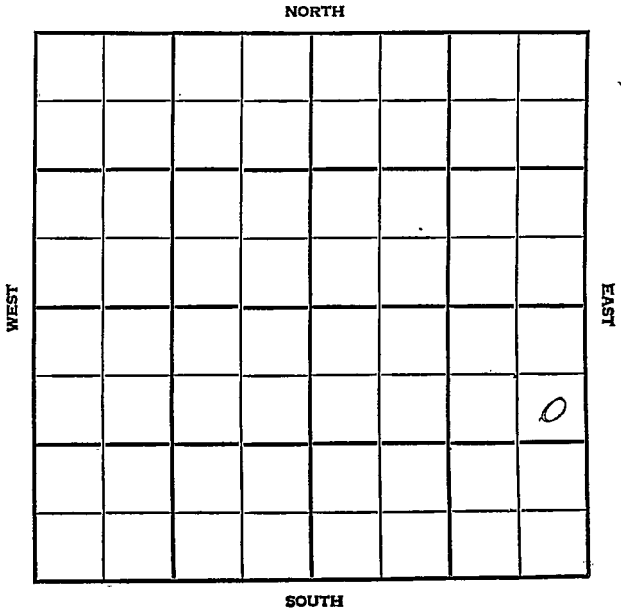

County Chase Elev. _____
 Sec. 24 Twp. 21 Rge. 9E
 Company Sauder & Throgmorton
 FarmName Hughes No. 1

TOPS	DEPTH	LOG	DATUM
Anh.			
Tp.			
H.			
Tr.			
Dg.			
Bl.			
L.			
K.C.			
B.K.C.			
Ce.			
C.			
M.			
M.			
K.			
Mz.			
Mo.			
V.			
S.			
S.			
A.			
R.			
PE.			
G.			
T.D.			

Loc. in Sec. SE NE SE
 Geol. _____
 Contr. _____
 Souders Tool Log
 Pool _____
 Atyeo-Pixlee

FIRST REPORT
 OCT 24 '55

Date Comm. spd. 10-16-56
10" @ 940, Drlg. 1075


SEE VIEW
 57

Handwritten signature

Co.
 Lsg.
 No.
 Sec.
 T.
 R.

County Chase Elev. _____
 Sec. 24 Twp. 21 Rgs. 9E
 Company Sauder & Throgmorton
 FarmName Hughes No. 1

TOPS	DEPTH	LOG	DATUM	Loc. in Sec.
Anh.				SE NE SE
TP.				200' FEW
H.				
Tr.				
Dg.				
BL.				
L. <u>Battl 2165</u>				Geol. _____
K.C. <u>" 2nd 2208-18</u>				Contr. _____
B.K.C.				Sauders Tool
Ce.				Pool _____
C.				Atyeo-Pixlee
M.				
M.				
K.				
Mz.				
Mq.				
V.				
S.				
S.				
A.				
R.				
PE.				
G.				
TD. <u>2222</u> 2278				

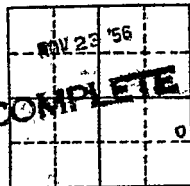

Date Comm. spd. 10-16-56

10" @ 940, Drlg. 1075 OCT 31 '56 NOV 7 '56

+ST 12 Bo nolw nat PB

2209 1/2 ~~4 1/2~~ to ~~2209 1/2~~ NOV 13 '56

9 1/2 @ 2211 100' oil 10 14

mes to frac NOV 21 '56 8 4 BopH

+Tr. wtr. P. est 20 Bopd

+10% wtr.