

Section 24 Township 21 Range 10 EWell No. # 1 RossilionCompany Robert Moore et al

NORTH

WEST

EAST

					0		

SOUTH

Lyon

KANSAS

Sec. 24 Twp. 21 R. 10E

Well No. #1 Fossilion Farm

Robert Moore et al Company

Contractor


Ft. from N. Line

330 Ft. from S. Line

Ft. from E. Line

990 Ft. from W. Line

SE SW SE

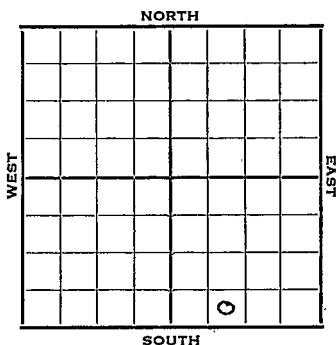

1952

REPORT

4/30
5/7

Location
Abd. location


ABANDONED

County Lyon State Kansas
 Sec. 24 (Blk. Twp.) 21 (Sur. Rge.) 10E Map No.

Operator Robert Moore et al.

Well No. 1 Farm Rossilion

Elev. Location SE SW SE

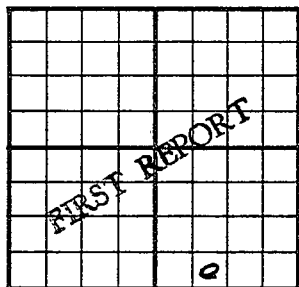

330 Ft. From S Line SE

990 Ft. From W Line Quarter

1st. Report APR 30 1952

Completion

Remarks

Spudding Date

Drlg. Data

Location


J. G. McGEHEE

County Lyon State Kansas
 Sec. 24 (Blk. Twp.) 21 (Sur. Rge.) 10E Map No.

Operator Robert Moore etal.

Well No. 1 Farm Rossilion

Elev. Location SE SW SE

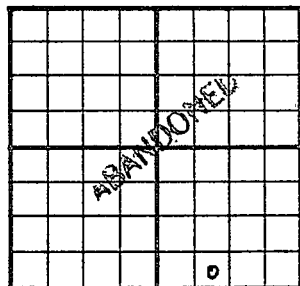

330 Ft. From S Line SE
990 Ft. From W Line Quarter

1st. Report

Completion MAY 7 1952

Remarks

Spudding Date

Drlg. Data

Abd. location

J. G. McGEHEE