


Map No. 100 Sec. 24 Twp. 21 R. 4

Well No. 1, Allison Farm

Sheedy et al Company

NORTH

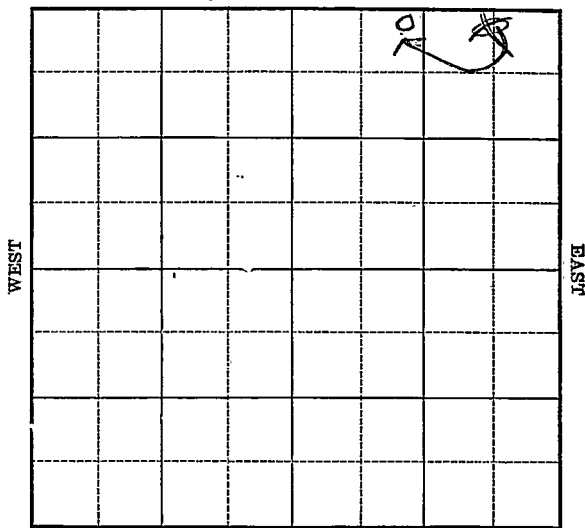

SOUTH

Location

Drilling Remarks

Rig Up_____

Drilling Remarks

RECORD

Cased_____in. _____ft.

Sand

Gas

Oil

Total Depth _____'

PRODUCTION

1st 24 hrs. Nat.-----

1st 24 hrs. after shot _____


Gas _____ cu. ft.

Dry Hole _____

Abandoned _____

Map No. Kansas Sec. 24 Twp. 21 R. 4Well No. 2 X Allison FarmSheedy et al Company

NORTH

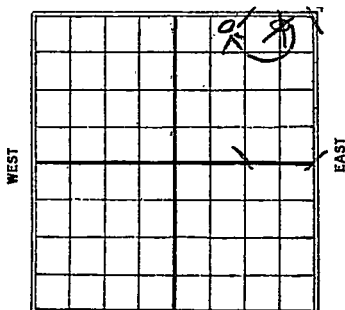

WEST

EAST

SOUTH

200 Ft. from N. Line

_____ Ft. from S. Line

~~100~~ Ft. from E. Line1120 Ft. from W. Line

Date

REPORT

19259/11Drilling 5009/16✓ 967'9/24✓ 1270'10/1✓ 165010/8✓ 216110/16Top sand 2390' - 3 ft in 1400'
oil in hole s.d. for orders10/22sand @ 2390 - 94 160 bbls
1st 24 hrs some 31.6 Gravity10/29Sand 2390 - 2394
Pumping 150 Bbls oil
10 Bbls Water

Nelson Co.
 Map No. **23** KANSAS Sec. **24** Twp. **21** R. **4**
 Well No. **1** *Ellison*
Sheedy et al Company

Contractor

FIRST REPORTS

SECTION PLAT

200 Ft. from N. Line

_____ Ft. from S. Line

660 Ft. from E. Line

_____ Ft. from W. Line

			10

Location _____

Rig up _____

Drilling and Remarks:

Only 500'

RECORD

Cased _____ in., _____ ft.

Sand _____

Gas _____

Oil _____

Total Depth _____

PRODUCTION

1st 24 hrs. Nat. _____

1st 24 hrs. after shot _____

Gas _____ Cu. Ft.

Dry Hole _____

Abandoned _____

Date

SEP 11 1925

CHAS. L. SHERWOOD

192

Scout

Map No. *23* **KANSAS** Sec. *24* Twp. *21* R. *14*

Well No. *1* *Ullison*
Shedy of *HL* Company

Contractor

CORRECTION

200 Ft. from N. Line

_____ Ft. from S. Line

_____ Ft. from E. Line

1170 Ft. from W. Line

SECTION PLAT

		<i>20</i>	<i>0</i>

Location _____

Rig up _____

Drilling and Remarks:

Delg 1270'

*Chg location
to above.*

RECORD

Cased _____ in., _____ ft.

Sand _____

Gas _____

Oil _____

Total Depth _____

PRODUCTION

1st 24 hrs. Nat. _____

1st 24 hrs. after shot _____

Gas _____ Cu. Ft.

Dry Hole _____

Abandoned _____

Date

SEP 25 1925

192 CHAS. L. SHERWOOD
Scout

Map No. *K23* KANSAS Sec. *34* Twp. *21* R. *4*

Well No. *2* *Alklow*
Shedy & Cap Co Company

Contractor

COMPLETED

SECTION PLAT

200 Ft. from N. Line

Ft. from S. Line

Ft. from E. Line

1/20 Ft. from W. Line

Location

Rig up

Drilling and Remarks:

Pumping 150 bbls oil

and 10 bbls Water

RECORD

Cased in. ft.

Sand *2290-2394*

Gas

Oil

Total Depth *2394'*

PRODUCTION

1st 24 hrs. Nat.

1st 24 hrs. after shot

Gas Cu. Ft.

Dry Hole

Abandoned

Date

OCT 29 1925

CHAS. L. SHERWOOD

192

Scout

Nations Co
 K23 KANSAS Sec. *24* Twp. *21* R. *14*
 Map No. _____
 Well No. *2 Allison*
Heedy & Empire Company
 _____ Contractor

CORRECTION

200 _____ Ft. from N. Line

_____ Ft. from S. Line

_____ Ft. from E. Line

1120 _____ Ft. from W. Line

SECTION PLAT

		0	

Location _____

Rig up _____

Drilling and Remarks:

umping 150 lbs oil
and 10 lbs water
chg well No to
above.

RECORD

Cased _____ in., _____ ft.

Sand *2390-2394*

Gas _____

Oil _____

Total Depth *2394*

PRODUCTION

1st 24 hrs. Nat. _____

1st 24 hrs. after shot _____

Gas _____ Cu. Ft.

Dry Hole _____

Abandoned _____

Date

OCT 29 1925

CHAS. L. SHERWOOD

192

Scout