

Form 51-5M-9-28-27423

5M-9-28-274
KANSAS

Sec.

.Twp

R.

34

Well No.

Farm

Company

NORTH

.							
.							
		①					

SOUTH

Location

Drilling Remarks

[illegible]

RECORD

Cased.....in.....ft.

Sand.....

Gas.....

Oil_____

Total Depth.....

Rig Up.

Drilling Remarks

[illegible]

PRODUCTION

1st 24 hrs. Nat.

1st 24 hrs. after shot.....

Gas.....cu. ft.

Dry Hole.....

Abandoned.....

Map No. Sec. Twp. R.

Well No. Farm


..... Company

..... Ft. from N. Line

..... Ft. from S. Line

..... Ft. from E. Line

..... Ft. from W. Line

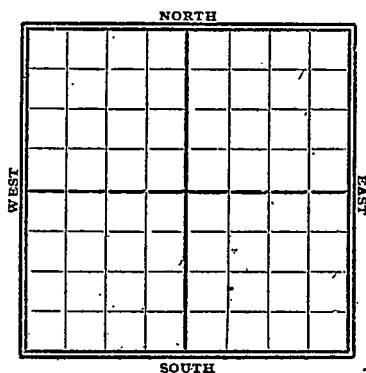

Date

REPORT

*Gypsy Records**8/23**Abd T.D. 2764'*

K24 KANSAS MAP NO. SEC. 24 TWP. 21 S R. 3 E

WELL NO. 1 Johnson

Creek & Co. COMPANY

CONTRACTOR

SECTION PLAT

ABANDONED

_____ FT. FROM N. LINE

_____ FT. FROM S. LINE

_____ FT. FROM E. LINE

_____ FT. FROM W. LINE

RECORD

LOCATION _____

CASED _____ IN. _____ FT.

RIG UP _____

SAND _____

DRILLING AND REMARKS:

GAS _____

OIL _____

TOTAL DEPTH 2764

PRODUCTION

1ST 24 HRS. NAT. _____

1ST 24 HRS. AFTER SHOT _____

GAS _____ CU. FT.

DRY HOLE ☒

ABANDONED ☒

DATE

8/73

1922

SCOUT