
Marion KANSAS

SECTION 25 TOWNSHIP 21S RANGE 4E

WELL NO. #7 Davis

COMPANY E.H. Adair

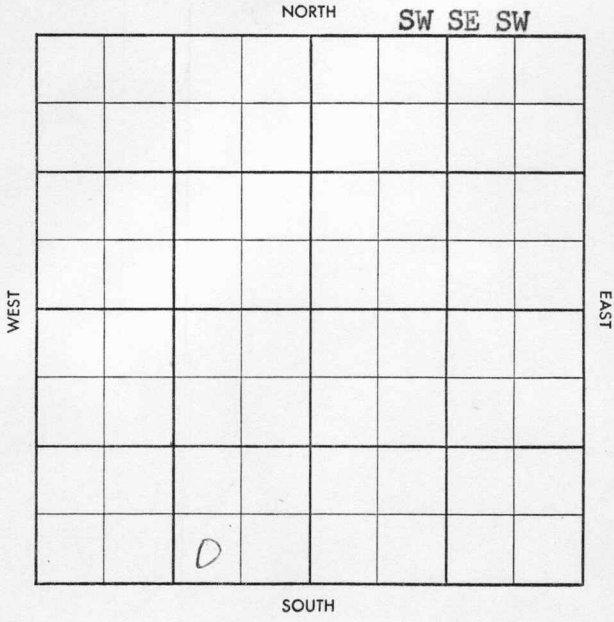

Twp. X Pool X

Co. X Facst. X

S-513-B

Co.

County Marion Elev.

Sec. 25 Twp. 21 Rge. 4E

Company E. H. Adair

Farm Name Davis No. 7

TOPS	DEPTH	LOG	DATUM
Anh.			
Tp.			
H.			
Tr.			
Dg.			
B. L.			
L.			
K.C.			
B.K.C.			
Ce.			
C.			
M.			
M.			
K.			
Mz.			
Mq.			
V.			
S.			
S.			
A.			
R.			
Pf.			
G.			
T.D.			

Loc. in Sec. SW SE SW

Geol.

Contr. Co. Tools

Pool Fairplay



Date Comm.

Location

Twp. X Pool X

Co. X Facet Y

S-513-B

County Marion Elev. 1416 DF 1419 RB

Sec. 25 Twp. 21 Rge 1E

Company T. H. Adair

Farm Name Davis No. 7

TOPS	DEPTH	LOG	DATUM
Anh.			
Tp.			
H.			
Tr.			
Dg.			
B. L.			
L.	1765		
K.C.			
B.K.C.	2117		
Ce.			
C.			
M.	2261		
M. Hunt	2456		
K.			
Mz.			
Mq.			
V.			
S.			
S.			
A.			
R.			
Pf.			
G.			
T.D.	2458		

Loc. in Sec. SW SW SW

Geol.

Contr. Co. Tools

Pool Fairplay

ABANDONED

MAY 21 '58

Date Comm. 5-10-58 8"16 $

Location APR 2 '58 APR 9 '58 APR 16 '58 APR 23 '58 APR 30 '58

MAY 7 '58 MAY 14 '58 Ø178 MAY 21 '58 DST 2259-79

of 24hrs 140' s OSPK in BHP 700

DST 2448-58 1hr 20' oil 20' cm

60' wm & 500' W BHP 800.

D&A

Co. Lse. No. Sec. T. R.