


Marion

KANSAS

SECTION 25 TOWNSHIP 21S RANGE 4E

WELL NO. #1 Mary Helen Davis

COMPANY Raymond

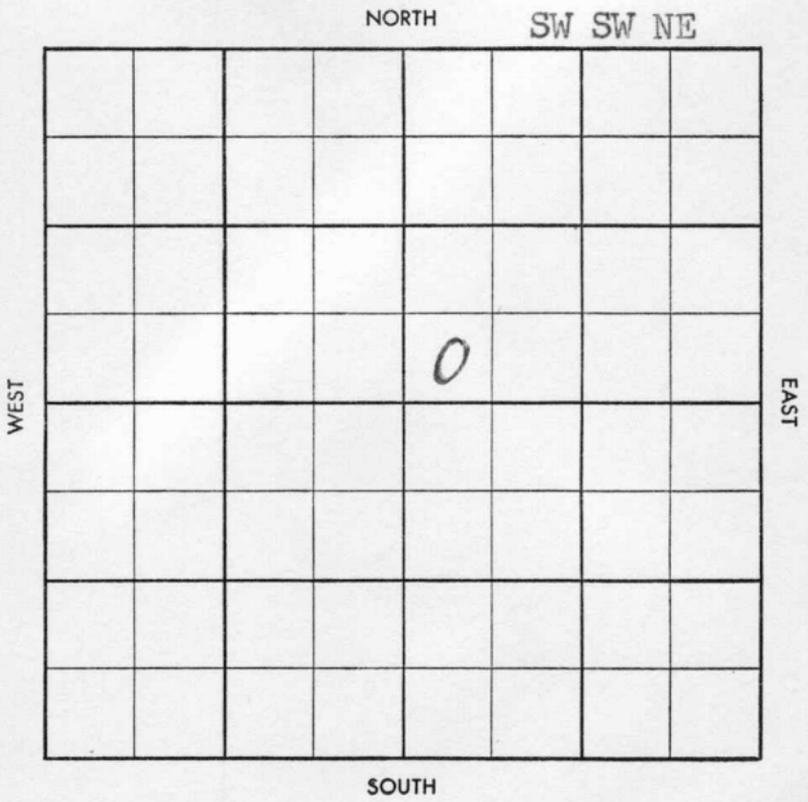

~~10~~

County Marion Elev. \_\_\_\_\_

Sec. 25 Twp. 21 Rge. 4E

Company Raymond

Farm Name Mary Helen Davis No. 1

TOPS	DEPTH	LOG	DATUM
Anh.			
Tp.			
H.			
Tr.			
Dg.			
B.L.			
L.			
K.C.			
B.K.C.			
Ce.			
C.			
M.			
M.			
K.			
Mz.			
Mq.			
V.			
S.			
S.			
A.			
R.			
Pf.			
G.			
T.D.			

Loc. in Sec. SW SW NE

Geol. \_\_\_\_\_

Contr. \_\_\_\_\_

Co. tools

Pool \_\_\_\_\_

Fairplay

FEB 19 58  
FIRST REPORT

Date Comm. \_\_\_\_\_

M I R

Co.  
Lse.  
No.  
Sec.  
T.  
R.

S-513-B

County Marion Elev. 1330KB  
 Sec. 25 Twp. 21 Rge. 4E  
 Company Raymond  
 Farm Name Mary Helen Davis No. 1

TOPS	DEPTH	LOG	DATUM
Anh.			
Tp.			
H.			
Tr.			
Dg.			
B.L.			
L.	<u>1689</u>		
K.C.			
B.K.C.	<u>2043</u>		
Ce.			
C.			
M. <u>Chert</u>	<u>2217</u>		
M. <u>Li</u>	<u>2293</u>		
K.	<u>2303</u>		
Mz. <u>K dol</u>	<u>2410</u>		
Mq. <u>Chert</u>	<u>2414</u>		
V. <u>m z</u>	<u>2431</u>		
S. <u>V</u>	<u>2436</u>		
S.			
A.			
R.			
Pf.			
G.			
I.D.	<u>2460</u>		

Loc. in Sec. SW SW NE  
 Geol. \_\_\_\_\_  
 Contr. Co. tools  
 Pool Fairplay



Date Comm. 2-20-58

M I REFR 26 58 8" 163 Ø 1885 MAR 5 1958

NO/09

D6A