
Form 51 5M 11-23 13896

Map No. Kansas Sec. 25 Twp. 21 R. 10

Well No. 1. Bradfield Farm

R. W. Talbot Company

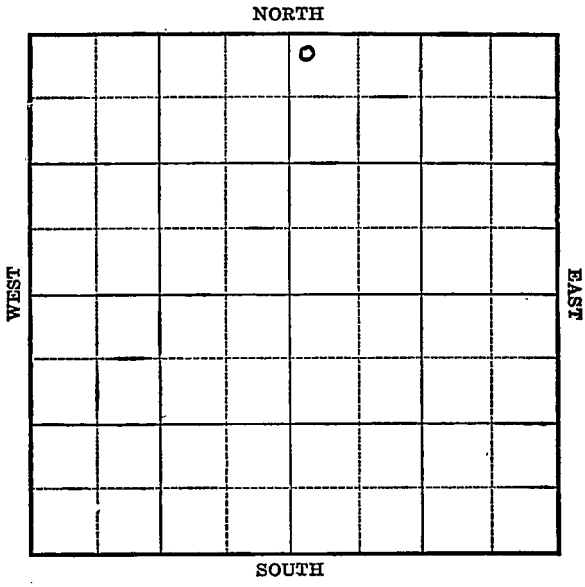

Location _____

Drilling Remarks:

Rig Up _____

Drilling Remarks:

RECORD

Cased _____ in. _____ ft.

Sand _____

Gas _____

Oil _____

Total Depth _____

PRODUCTION

1st 24 hrs. Nat. _____

1st 24 hrs. after shot _____

Gas _____ cu. ft.

Dry Hole _____

Abandoned _____

Form 252A 5M 8-24 16529

Map No. Kansas Sec. 25 Twp. 21 R. 10

Well No. 1 Bradfield Farm


R. W. Talbot Company

200 Ft. from N. Line

Ft. from S. Line

Ft. from E. Line

200 Ft. from W. Line

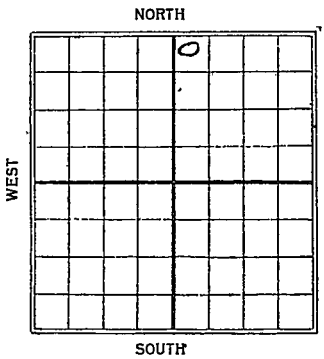

C.

Date 1925	REPORT
5/1	Dly 500
5/9	S.D. 1200
6/5	—
6/12	—
6/19	—
6/26	—
7/3	1600
7/10	10" @ 1690 S.D.
7/17	1700
7/24	S.D. 1700' Lester blew up
7/31	— — —
8/7	1820'
8/14	—
8/19	Top Lime 2255' Dly 2270'
8/26	Running 6" — 2310'
9/3	W.R. 6" to 2400'
9/11	2420'
9/16	W.R. 6" @ 2500
9/24	—
10/1	Top Chilcot 2585 - 1/2 in sand H.O. Hayes 25.4 Ge.

10/11 Pumped 2508 Hrs - Shoe rods parted

10/16 ———

10/22 — 8.D. Lay line pipe
line to Rail Road

11/6 - Sand 2585—86
300 Bbls oil
25.4 Gravity

Form 26—1M Bks.—3-23—11959.


Map No. 21 Kern Sec. 25 Twp. 21 R. 10

Well No. 1 Brad Field

R. W. Zulhoff Company

Contractor

SECTION PLAT

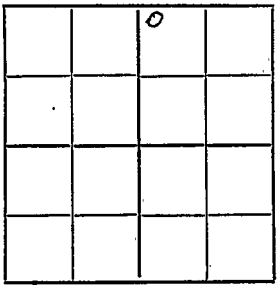

200 Ft. from N. Line

Ft. from S. Line

Ft. from E. Line

200 Ft. from W. Line

FIRST REPORTS

Location

Rig up

Drilling and Remarks:

Drlg 500'

RECORD

Cased in., ft.

Sand

Gas

Oil

Total Depth

PRODUCTION

1st 24 hrs. Nat.

1st 24 hrs. after shot

Gas Cu. Ft.


Dry Hole

Abandoned

Date

MAY 1 192

CHAS. L. SHERWOOD Scout

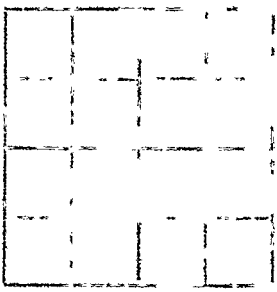

Returned
Cards
Tracing
J. S. C. map
Gast map
Moody map
Gast plat book
Moody plat book

Form 26—1M Bks.—3-23—11959. Lyon Co

Map No. K 21 KANSAS Sec. 25 Twp. 21 R. 10

Well No. 1 Bradfield

E. M. Talbot Company

Contractor

COMPLETED


706 Ft. from N. Line

Ft. from S. Line

Ft. from E. Line

700 Ft. from W. Line

SECTION PLAT

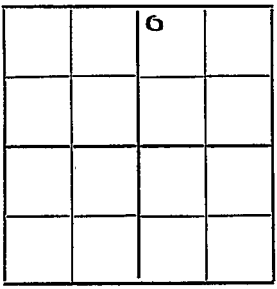

Location Wilcox

Rig up

Drilling and Remarks:

Top Lime 2252'

300 bbls. oil

Left 75.4 Sherwood

RECORD

Cased in., ft.

Sand 2595-2586'

Gas

Oil

Total Depth 2586'

PRODUCTION

1st 24 hrs. Nat.

1st 24 hrs. after shot

Gas Cu. Ft.

Dry Hole

Abandoned


Date

NOV 6 1925

192

CHAS. L. SHERWOOD

Scout

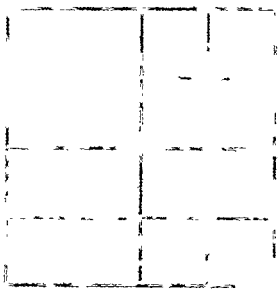

Returned

Cards

Tracing

France Map

Scarborough Map

Moody Map

Scarborough Plat Book

Moody Plat Book