


Lyon

Map No. *1st* Sec. *25* Twp. *21* R. *10*

Well No. *1-L. E. Bradfield* Farm
Jackson & Wise Company

..... Ft. from N. Line
990 Ft. from S. Line
330 Ft. from E. Line
 Ft. from W. Line

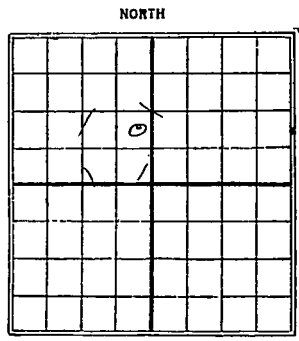

1926


Date	REPORT
<i>10/13</i>	<i>R.O.G.</i>
<i>10/27</i>	<i>Rig</i>
<i>11/11</i>	<i>Rigging up</i>
<i>11/17</i>	<i>Spudding</i>
<i>11/23</i>	<i>Drlg 700'</i>
<i>12/8</i>	<i>" 1680</i>
<i>12/15</i>	<i>" 1975'</i>
<i>12/22</i>	<i>S.D. 1975</i>
<i>12/30</i>	<i>Drlg 2160</i>
<i>1927</i>	
<i>1/6</i>	<i>Drilling 2400</i>
<i>1/13</i>	<i>Top sand 2540 - hole full oil</i>
<i>1/19</i>	<i>Sand 2543-2547</i> <i>500 bbls.</i>

Lyon

21 KANSAS Map No. Sec. 35 Twp. 21 R. 10

Well No. 1 L. E. Bradfield Farm
Jacobsen & Wise Company

NORTH

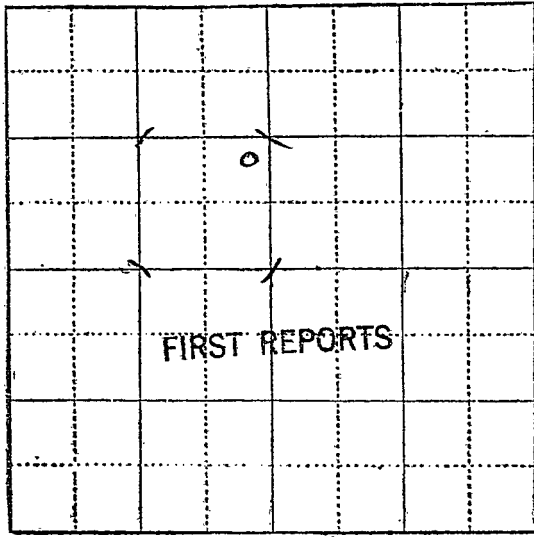

SOUTH

Location _____

Rig up _____

Drilling and Remarks:

Log

RECORD

Cased _____ in., _____ ft.
 Sand _____
 Gas _____
 Oil _____
 Total Depth _____

PRODUCTION

1st 24 hrs. Nat. _____
 1st 24 hrs. after shot _____
 Gas _____ Cu. Ft.
 Dry Hole _____
 Abandoned _____

Date

OCT 13 1926

CHAS. L. SHERWOOD
Scout

Lyon

21 KANSAS

Map No. _____ Sec. *25* Twp. *21* R. *10*

Well No. *1 L. E. Bradford*

Jackson & Wise Company

Contractor

COMPLETED

SECTION PLAT

_____ Ft. from N. Line

990 Ft. from S. Line

330 Ft. from E. Line

_____ Ft. from W. Line

	/	o	\
	\	/	

Location _____

Rig up _____

Drilling and Remarks:

500 lbs rat.

RECORD

Cased _____ in., _____ ft.

Sand *2543-2547*

Gas _____

Oil _____

Total Depth *2547*

PRODUCTION

1st 24 hrs. Nat. _____

1st 24 hrs. after shot _____

Gas _____ Cu. Ft.

Dry Hole _____

Abandoned _____

Date

JAN 19 1927

CHAS. L. SHERWOOD

192

Scout