


Section 25 Township 21 Range 10 E

Well No. #5 Perrier

Company Wixson

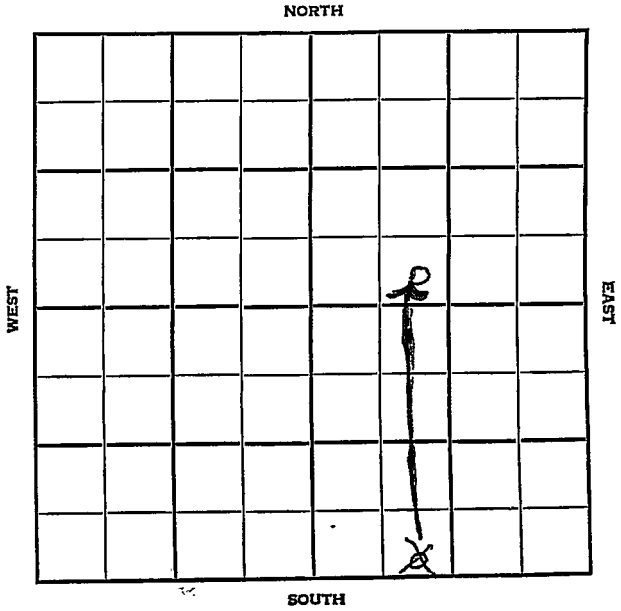

Lyon

KANSAS

~~SUCALIN~~

SEC. 25	TWP. 21	R. 10E
------------	------------	-----------

WELL NO. #5 Perrier FARM

COMPANY Wixson

CONTRACTOR Co Tools
Bradfield


_____ Ft. from N. Line

~~150~~ 330 Ft. from S. Line

_____ Ft. from E. Line

990 Ft. from W. Line

SE SW ~~SE~~ ^{NE}

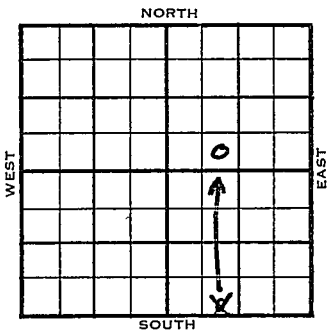

	ELEVATION	REPORT
1955	--	

10/5 Comm 9-10-55
13" @ 670 10" @ 1120
Drlg 1510

10/19 Comm. 9-10-55
13" @ 670 10" @ 1120
7" @ 2203/30 GO to 2223' 1000 A
P/35 BO 1 day.
Comp. 25 BOPD 60 BW
L. 1117', KC 1270', M. 2140'
TD 2222'

COMPLETED

No County

County Lyon Elev. _____

Sec. 25 Twp. 27 Rge. 10E

Company Wilson

FarmName Perrier No. 5

TOPS	DEPTH	LOG	DATUM
Anh.			
Tp.			
H.			
Tr.			
Dg.			
Bl.			
L.			
K.C.			
B.K.C.			
Ce.			
C.			
M.			
M.			
K.			
Mz.			
Mo.			
V.			
S.			
S.			
A.			
R.			
PE.			
G.			
T.D.			

Loc. in Sec. _____

SE SW SE

150' SL

Geol. _____

Contr. _____

Co. tools

Pool _____

Bradfield

OCT 5 1955	
FIRST REPORT	
0	

Date Comm. 9-10-55

13" @ 670 10" @ 1120 drlg. 1510

Co.

Lsec.

No.

Sec.

T.

R.

OCT 7 1955

Scout Cards	<u>mm</u>
Land Small Map	_____
Land Wall Map	_____
Tracings	_____
France Map	_____
Pierce Map	_____
Misc.	_____

Scout Cards	<i>mm</i>
Land Small Map	_____
Land Wall Map	_____
Troopings	_____
France Map	_____
Pierce Map	_____
Misc.	_____

NOV 2 1955

County	Lyon	Elev.	
Sec.	25	Twp.	21
		Rge.	10E
Company	Wixson		
FarmName	Perrier	No.	5

TOPS	DEPTH	LOG	DATUM	Loc. in Sec.
Anh.				SE SW NE
Tr.				
H.				
Tr.				
Dg.				
Bl.				
L.	1117			Geol.
K.C.	1270			Contr.
B.K.C.				
Ce.				Co. tools
C.				
M.	2140			Pool
M.				
K.				Bradfield
Mz.				
Me.				
V.				
S.				
S.				
A.				
R.				
Pe.				
G.				
TD.	2222			

Date Comm.	9-10-55	OCT 19 1955
	13" @ 670	, 10" @ 1120
		7" @ 2203/30
	CO to 2223	1000 A P/ 35 bo 1 day
	Comp. 25 bopd	60 bw

COMPLETE

First reported as SE SW SE

Completed as SE SW NE.

Please advise.

Mickey

Scouting Dept.

Scout Cards	<i>mm</i>
Land Small Map
Land Wall Map
Tracings
France Map
Pierce Map
Misc.

NOV 2 1955