


Lyon

Map No. _____ Sec. *25* Twp. *21* R. *10*

Well No. *1* *Bradfield* Farm
Ritchie & Snover Company

NORTH

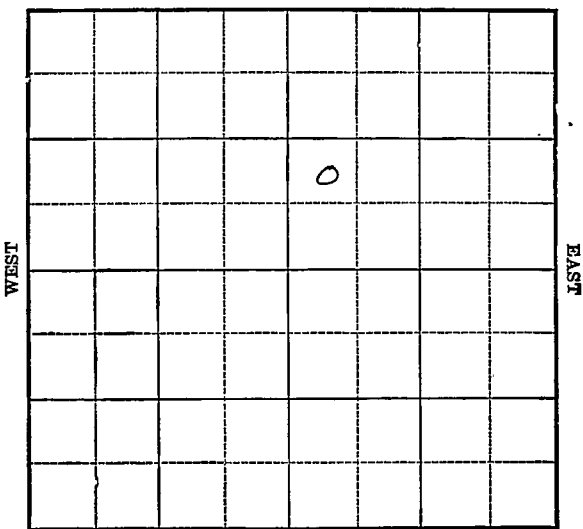

SOUTH

Location _____
Drilling Remarks _____

Rig Up _____
Drilling Remarks _____

RECORD

PRODUCTION

Cased _____ in. _____ ft.

Sand _____

Gas _____

Oil _____

Total Depth _____

1st 24 hrs. Nat. _____

1st 24 hrs. after shot _____

Gas _____ cu. ft.

Dry Hole _____

Abandoned _____

Lyon

Map No. *Kans* Sec. *25* Twp. *21* R. *10*

Well No. *1* *Bradfield* Farm


Ritchie & Moore Company

..... Ft. from N. Line

990 Ft. from S. Line

..... Ft. from E. Line

330 Ft. from W. Line

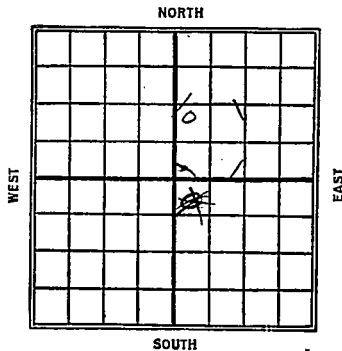

1926

Date

REPORT

9/22 Bldg rig

9/29 rigging up

10/13 Drlg 920'

10/27 Drlg 2240

11/10 sand 2579-2589

oil 2584 300 bbls

27 gravity

Hyon

Map No. 21 KANSAS Sec. 25 Twp. 21 R. 10

Well No. 1 *Bradfield*
Hitchie & Moore Company

Contractor

FIRST REPORTS

SECTION PLAT

_____ Ft. from N. Line

990 Ft. from S. Line

_____ Ft. from E. Line

330 Ft. from W. Line

		/	/
		/	/

Location _____

Rig up _____

Drilling and Remarks:

Blow Rig

RECORD

Cased _____ in., _____ ft.

Sand _____

Gas _____

Oil _____

Total Depth _____

PRODUCTION

1st 24 hrs. Nat. _____

1st 24 hrs. after shot _____

Gas _____ Cu. Ft.

Dry Hole _____

Abandoned _____

Date

SEP 22 1926

CHAS. L. SHERWOOD

Scout

Map No. 21 KANSAS Sec. 25 Twp. 21 R. 10

Well No. 1 Bradfield
Hitchie & Moore Company

Contractor

COMPLETED

SECTION PLAT

_____ Ft. from N. Line

990 Ft. from S. Line

_____ Ft. from E. Line

330 Ft. from W. Line

		a	

Location _____

Rig up _____

Drilling and Remarks:

oil 2584'

300 lbs

27° S.W. 1/4

RECORD

Cased _____ in. _____ ft.

Sand 2579-2589'

Gas _____

Oil _____

Total Depth 2589'

PRODUCTION

1st 24 hrs. Nat. _____

1st 24 hrs. after shot _____

Gas _____ Cu. Ft.

Dry Hole _____

Abandoned _____

Date

NOV 11 1926

CHAS. L. SHERWOOD

192

Scout