
Marion KANSAS

SECTION 26 TOWNSHIP 21 S RANGE 3 E

WELL NO. # 1 Nusbaum

COMPANY Petroleum Inc.

NORTH SW SW NW

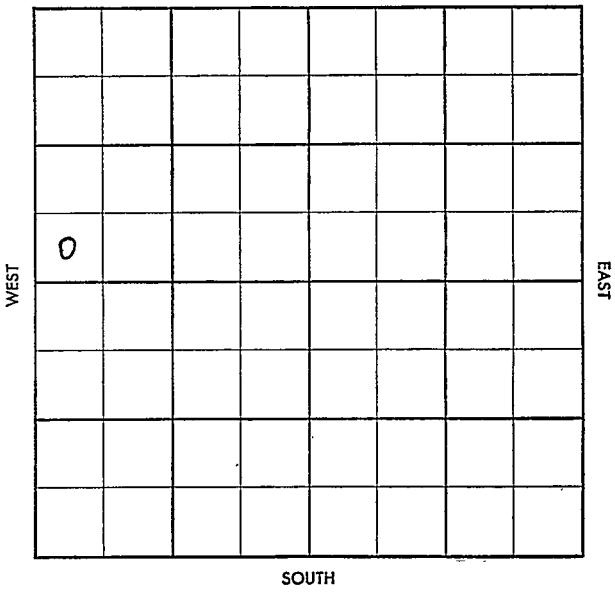

FORM 504-3 SUNRAY

WILDCAT

S-513-B

County Marion Elev.

Sec. 26 Twp. 21S Rge. 3E

Company Petroleum Inc.

Farm Name Nusbaum No. 1

TOPS	DEPTH	LOG	DATUM
Anh.			
Tp.			
H.			
Tr.			
Dg.			
B.L.			
L.			
K.C.			
B.K.C.			
Ce.			
C.			
M.			
M.			
K.			
Mz.			
Mq.			
V.			
S.			
S.			
A.			
R.			
Pf.			
G.			
T.D.			

Loc. in Sec. SW SW NW

Geol. Stump

Contr. Garvey Tools Rig 1

Pool Wildcat


FIRST REPORT

SEP 11 58

Date Comm. 9/5/58

8" @ 205 Drlg 2109

Co. Lse. No. Sec. T. R.

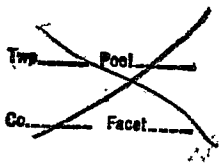

S-513-B

County Marion Elev.

Sec. 26 Twp. 21S Rge. 3E

Company Petroleum Inc.

Farm Name Nusbaum No. 1

TOPS	DEPTH	LOG	DATUM
Anh.			
Tp.			
H.			
Tr.			
Dg.			
B.L.			
L.	1930		
K.C.	2059		
B.K.C.	2272		
Ce.			
C.			
M.	2484		
M. LI	2591		
K.	2659		
Mz. Hunt	2792		
Mq.	2809		
V.	2947		
S.			
S.			
A.			
R.			
Pf.			
G.			
T.D.	2859		

Loc. in Sec. SW SW NW

Geol. Stump

Contr. Garvey Tools Rig 1

Pool Wildcat

ABANDONED

o

SEP 17 '58

Date Comm. 9/5/58

8" @ 205 Drlg 2109 SEP 17 '58 DST 2485-90 60" 145'SW BHP720/20" DST 2793-99 60" 760'W BHP 1030 DST 2843-47 60" 5'OCM BHP698/20"

D&A

Co. Lse. No. Sec. T. R.