


Marion

KANSAS

SECTION 26 TOWNSHIP 21S RANGE 4E

WELL NO. #1 DeForest "C"

COMPANY E. H. Adair

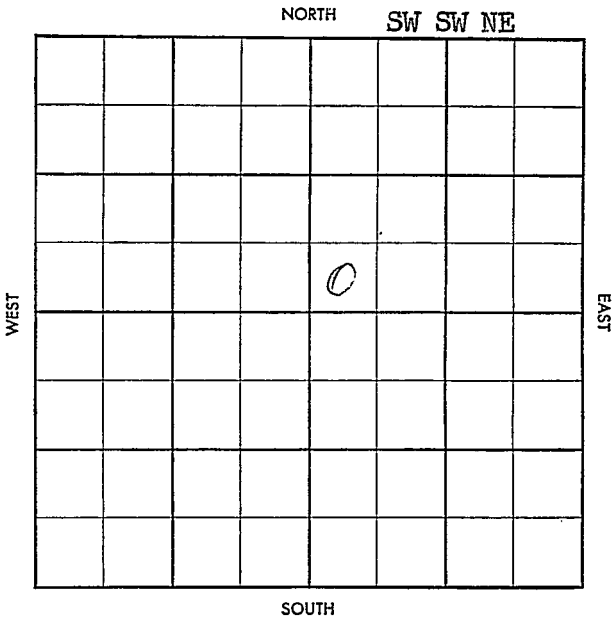

~~Twp. 26 N. R. 21 E.~~
~~Sec. 26~~

S-513-B

County Marion Elev. _____
 Sec. 26 Twp. 21 Rge. 4E
 Company E. H. Adair
 Farm Name Deforest "C" No. 1

TOPS	DEPTH	LOG	DATUM
Anh.			
Tp.			
H.			
Tr.			
Dg.			
B.L.			
L.			
K.C.			
B.K.C.			
Ce.			
C.			
M.			
M.			
K.			
Mz.			
Mq.			
V.			
S.			
S.			
A.			
R.			
Pf.			
G.			
T.D.			

Loc. in Sec. SW SW NE
 Geol. _____
 Contr. _____
 Co. Tools _____
 Pool _____
Fairplay

FIRST REPORT
APR 23 58

Date Comm. 4/20/58
8" @ 163 Drlg. 1260.

Co. Lse. No. Sec. T. R.

~~Top~~ ~~Pool~~
~~Co.~~ ~~Foot~~

5-513-B

County Marion Elev. 1405 OF 1408 RB
 Sec. 26 Twp. 21 Rge. 4E
 Company E. H. Adair
 Farm Name Deforest "C" No. 1

TOPS	DEPTH	LOG	DATUM
Anh.			
Tp.			
H.			
Tr.			
Dg.			
B.L.			
L.	<u>1775</u>		
K.C.			
B.K.C.	<u>2128</u>		
Ce.			
C.			
M.	<u>Chat 2272</u>		
M.	<u>Li 2329</u>		
K.	<u>2339</u>		
Mz.	<u>Chat 2468</u>		
Mq.	<u>Mont 2483</u>		
V.			
S.			
S.			
A.			
R.			
Pf.			
G.			
T.D.	<u>2490</u>		

Loc. in Sec. SW SW IE

Geol. _____
 Contr. _____
 Co. Tools _____

Pool Fairplay

ABANDONED
 0
 MAY 14 '58

Date Comm. 4/20/58
 8" @ 163 Drlg. 1260. 450 30 58 DST 2273-2329
1 hr 210' 0 Spt m FP 146 B NP 960-790/20'
no log 5" 246 275 1 58 MAY 14 '58
to 2990 frac \$ 6 BW D h

D 6 A

Co. _____
Lse. _____
No. _____
Sec. _____
T. _____
R. _____