


SECTION 26 TOWNSHIP 21 RANGE

WELL NO. #1 Depler

COMPANY Ed Adair & Lee Phillips

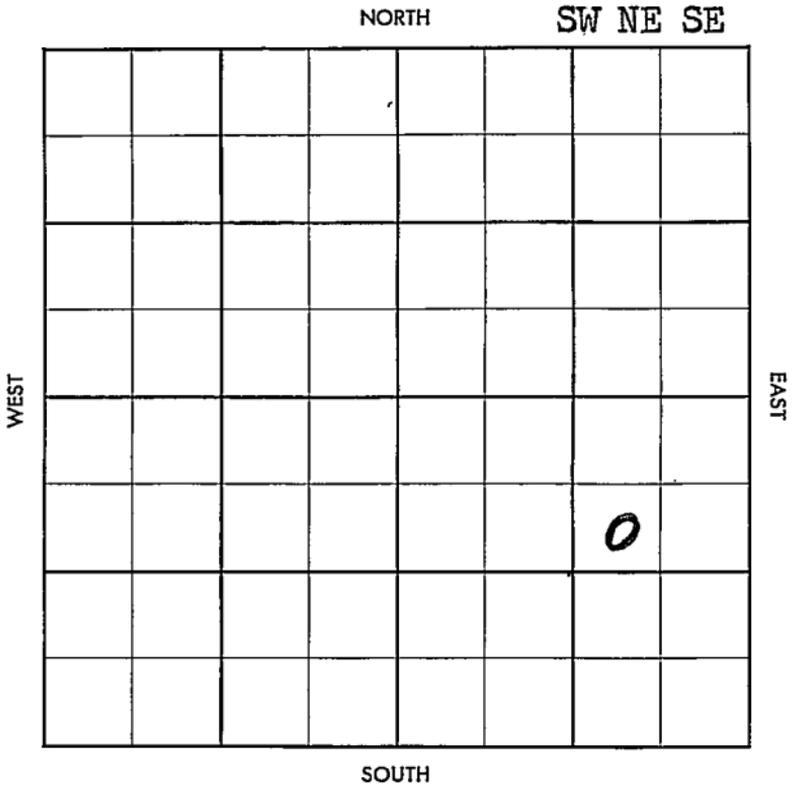

WILDCAT


FORM 513 SUNRAY

County Macon Elev. _____
 Sec. 26 Twp. 21 Rgs. 4E
 Company Ed Adair & Lee Phillips
 Farm Name Depler No. 1

TOPS	DEPTH	LOG	DATUM	Loc. in Sec.
Anh.				SW NE SE
Tp.				
H.				
Tr.				
Dg.				
Bl.				
L.				Geol. _____
K.C.				Contr. _____
B.K.C.				
Ce.				<u>Adair Tools</u>
C.				
M.				Pool _____
M.				<u>Wildcat</u>
K.				
Mz.				
Ma.				
V.				
S.				
S.				
A.				
R.				
Pe.				
G.				
T.D.				FIRST REPORT

JUL 3 '57

Date Comm. 6-30-57
8" @ 145 - Drlg. below surface

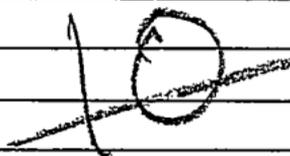

Co.

County Marion Elevation 1467 DF
 Sec. 26 Twp. 21 Rge. 4E
 Company Ed Adair & Lee Phillips
 Farm Name Depler No. 1

TOPS	DEPTH	LOG	DATUM
Anh.			
Tp.			
H.	X 1504		
Tr.			
Dg.			
Bl.			
L.	1770		
K.C.			
B.K.C.	2126		
Ce.			
C.			
M.	2270		
M.			
K.	2318		
Mz.	chata 2446		
Mo.	Mz 2448		
V.	2449		
S.			
S.			
A.			
R.			
PE.			
G.			
TD.	2460		

Loc. in Sec. SW NE SE
 Geol. _____
 Contr. Adair Tools
 Pool Wildcat
ABANDONED
 JUL 10 '57

Loc.

No.

Sec.

T.

R.

Date Comm. 6-30-57

8" @ 145 - Drig. below surface
Tops DST 2453-60 1hr run 200'
50c sulph wtr + 760' sulph wtr FP
6-446 BIT 780/20" RTP 2460
N.L.
DEA