

Marion


KANSAS

SECTION 26 TOWNSHIP 21S RANGE 4E

WELL NO. #2 Depler

COMPANY E.H. Adair & Lee Phillips

NORTH SE SE SE

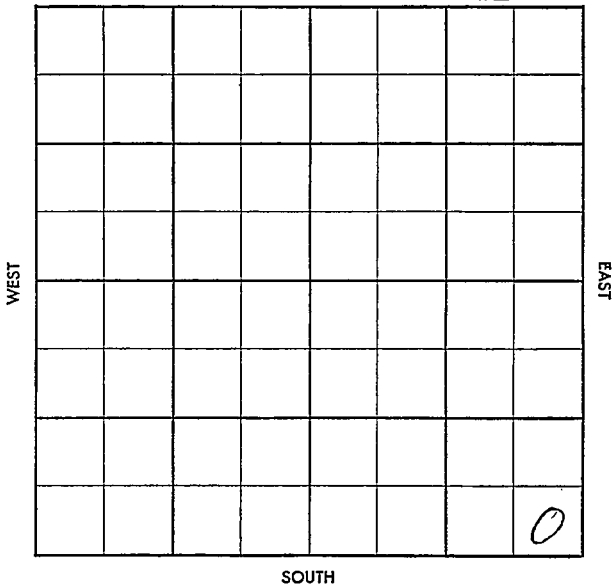

10

CO. Marion ELEV. \_\_\_\_\_  
SEC. 26 TWP. 21 RGE. 4E  
COMPANY E. H. Adair NO. 2

FIRST REPORT	
DEC 26 '57	

FARM Depler  
LOC. SE SE SE


GEOL. \_\_\_\_\_  
 CONTR. Cc. Tools  
 POOL Fairplay  
 SPUD \_\_\_\_\_  
Simp test RURT  
 \_\_\_\_\_  
 \_\_\_\_\_  
 \_\_\_\_\_

CO. T  
LSE.  
NO.  
SEC.  
TWP.  
RGE.

CORRECTION

10

S-513-A

CO. Marion ELEV. 1422' B 14190'

FEB 26 '58

SEC. 26 TWP. 21 RGE. 4E

COMPLETE

COMPANY E. I. Sear & NO. 2

Lee Phillips

FARM Deplet

LOC. S1/4 SE SL

✓
L 1774
DKL 2430
M 2278
K 2323
Chetn 2436
Uio 2450
TD 2452

GEOL. \_\_\_\_\_  
 CONTR. Co. Tools \_\_\_\_\_  
 POOL Fairplay \_\_\_\_\_  
 SPUD 1-2-58 \_\_\_\_\_  
 Simp set ALRT \_\_\_\_\_  
 JAN 2 '58 JAN 8 '58 8 1/4 163 \_\_\_\_\_  
 DST 2442-52 30' \_\_\_\_\_  
 630' oil BHP \_\_\_\_\_  
 840-830/30 \_\_\_\_\_  
 5 1/2 2450 CO \_\_\_\_\_

2452 TD FU 1600' oil NW

2 hrs pop wopot JAN 15 '58 JAN 22 '58

JAN 29 '58 FEB 5 '58 FEB 12 '58 FEB 19 '58 FEB 26 '58

Phy P III BODD NW

9-38°

VIOLO

CO. LSE. NO. SEC. TWP. RGE.