


Section 26 Township 21 Range 13E

Well No. #1 Rainbolt

Company Bill Taylor

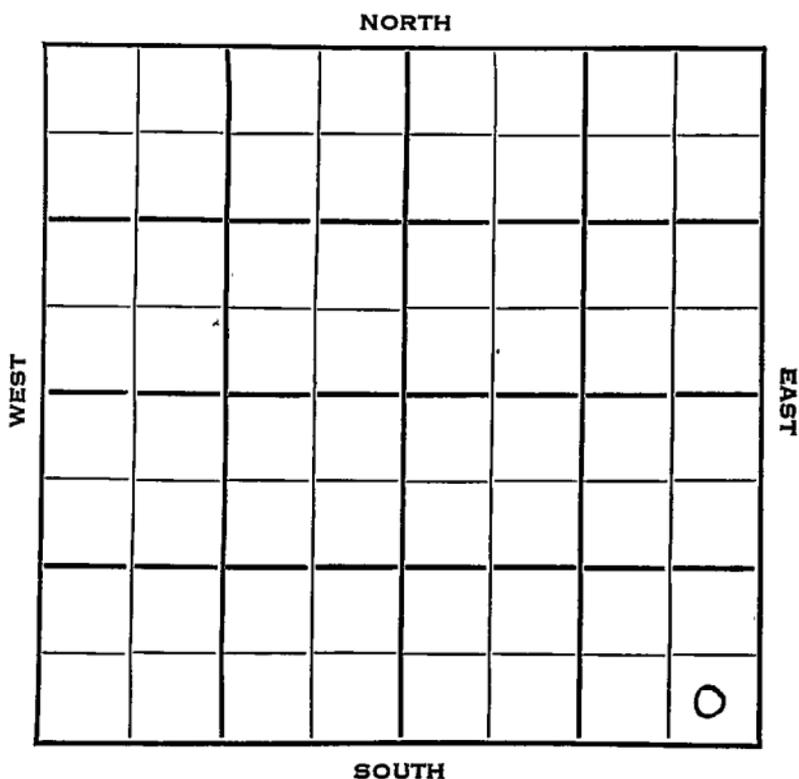

Coffey

KANSAS ✓


SEC.	TWP.	R.
26	21	13E

WELL NO. **1 Rainbolt** FARM

COMPANY **Bill Taylor**

CONTRACTOR **Ola Berentz**

_____ Ft. from N. Line
330 _____ Ft. from S. Line
330 _____ Ft. from E. Line
 _____ Ft. from W. Line

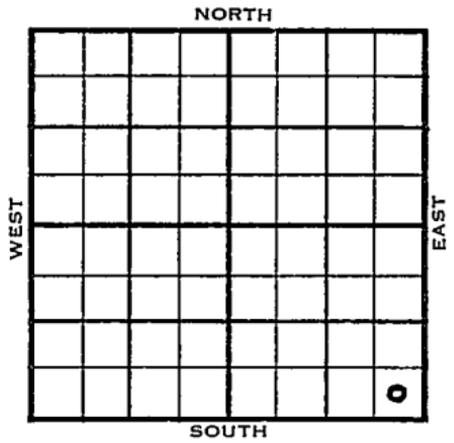

SE SE SE

1953	ELEVATION	REPORT
------	-----------	--------

9/23

Spud 9-1-53
 D&A
 TD 1917'
 10" @ 745'
 8" @ 1365'
 5" @ 1800'
 Burgess sd 1868, Miss 1884
 TD 1917
 D&A

FIRST REPORT

ABANDONED

