


Section 26 Township 21 Range 13 E

Well No. # 1 D. T. Todd

Company James D. Taylor

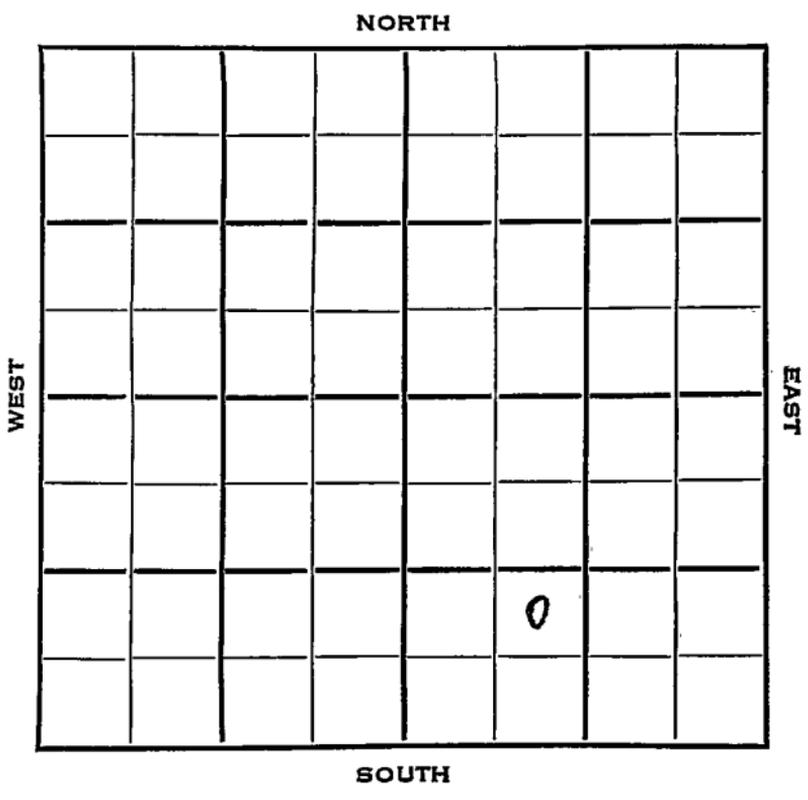

Coffey

KANSAS

SEC.	TWP.	R.
26	21	13E

WELL NO. 1 D. T. Todd FARM

COMPANY James D. Taylor

CONTRACTOR Berentz

_____ Ft. from N. Line	
990 Ft. from S. Line	
_____ Ft. from E. Line	
990 Ft. from W. Line	

NE SW SE

1953	ELEVATION	REPORT
	=	

10/21	Spud 9-28-53 8" @ 42' Sq. sd 1500' Burg. 1848-62' 5" @ 1775 Drlg. 1850'
10/28	Spud 9-28-53 D & A TD 1893 8" @ 42' Sq. sd. 1500 Burgess 1848- 62' 5" @ 1775 Miss 1863 TD 1893' D & A

ABANDONED

