

Lyon

Map No. Kansas Sec. 26 Twp. 21 R. 12


Well No. 1 French Farm
G. W. Gasche et al Company

330 Ft. from N. Line

_____ Ft. from S. Line

_____ Ft. from E. Line

330 Ft. from W. Line

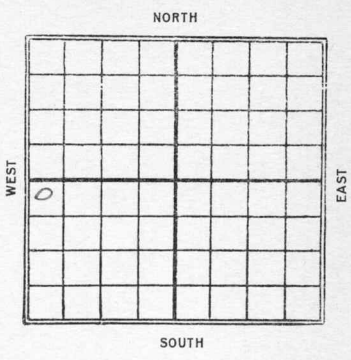

Date	REPORT
1927	
5/25	machine
6/1	_____
6/7	slg 500
6/15	Setting 10" - 950.
6/22	Drlg 1300
6/29	" 1650
7/13	sand 1800-37-H.F.W.
	D. & A. 2018

Lyon

21 KANSAS
Map No. _____ Sec. *26* Twp. *21* R. *12*

Well No. *1* *French*

S. W. Sosche et al Company

Contractor

COMPLETED

330 Ft. from N. Line

_____ Ft. from S. Line

_____ Ft. from E. Line

330 Ft. from W. Line

SECTION PLAT

<i>0</i>			

ABANDONED

Location _____

Rig up _____

Drilling and Remarks:

and 1800-37 ft

1917 2018

RECORD

Cased _____ in., _____ ft.

Sand _____

Gas _____

Oil _____

Total Depth *2018*

PRODUCTION

1st 24 hrs. Nat. _____

1st 24 hrs. after shot _____

Gas _____ Cu. Ft.

Dry Hole

Abandoned

Date _____

July 13 1927 CHAS. L. SHERWOOD Scout

Lyon

Map No. 21 KANSAS Sec. 26 Twp. 21 R. 12

Well No. 1 French

S. W. Sasche et al Company

Contractor

FIRST REPORTS

SECTION PLAT

330 Ft. from N. Line

----- Ft. from S. Line

----- Ft. from E. Line

330 Ft. from W. Line

0			

Location -----

Rig up -----

Drilling and Remarks:

Machining

RECORD

Cased ----- in., ----- ft.

Sand -----

Gas -----

Oil -----

Total Depth -----

PRODUCTION

1st 24 hrs. Nat. -----

1st 24 hrs. after shot -----

Gas ----- Cu. Ft.

Dry Hole -----

Abandoned -----

Date

MAY 25 1927

CHAS. L. SHERWOOD

192

Scout