


Section 27 Township 21 Range 5E

Well No. 1 Litton

Company Hex & Morris et al

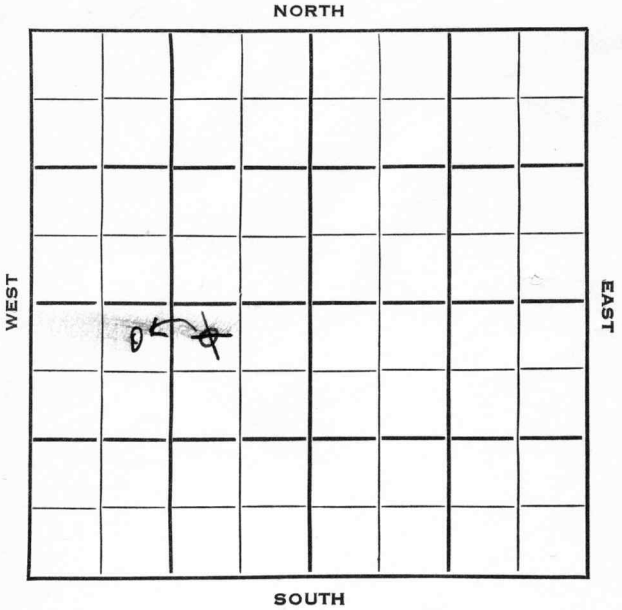

Sec. 27 Twp. 21 R. 5E

Well No. #1 Litton Farm

Rex & Morris et al Company

Rex & Morris Contractor

330 Ft. from N. Line


Ft. from S. Line

990 Ft. from E. Line

990 Ft. from W. Line

~~NW NE SW~~

NE NW SW

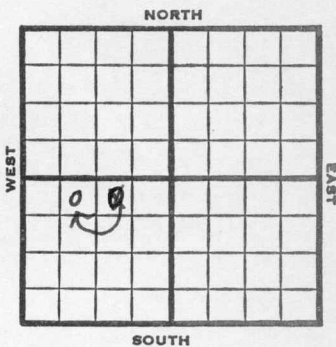

1953

Elev. 1443' REPORT

7/29

Spud 7-25-53  
10" @ 55  
8" @ 125, WOC

8/5

Spud 7-25-53  
D & A  
TD 2478'  
10" @ 55'  
8" @ 125'  
Lans 1755, Miss 2457  
TD 2478'  
D & A

**ABANDONED**





Kansas

Map No. \_\_\_\_\_ Sec. 27 Twp. 21 R. 5E

Well No. 1 Litton

Rex & Morris Company

**CORRECTION**

Contractor

NE NW SW

SECTION PLAT

330 Ft. from N. Line

\_\_\_\_\_ Ft. from S. Line

\_\_\_\_\_ Ft. from E. Line

990 Ft. from W. Line

|   |  |  |  |
|---|--|--|--|
|   |  |  |  |
|   |  |  |  |
| o |  |  |  |
|   |  |  |  |

Marion County

Location \_\_\_\_\_

Rig up \_\_\_\_\_

Drilling and Remarks:

RECORD

Cased \_\_\_\_\_ in., \_\_\_\_\_ ft.

Sand \_\_\_\_\_

Gas \_\_\_\_\_

Oil \_\_\_\_\_

Total Depth \_\_\_\_\_

PRODUCTION

1st 24 hrs. Nat. \_\_\_\_\_

1st 24 hrs. after shot \_\_\_\_\_

Gas \_\_\_\_\_ Cu. Ft.

Dry Hole \_\_\_\_\_

Abandoned \_\_\_\_\_

Reported  
NW NE SW

Date

AUG 5 1953 19

J. G. McGEHEE Scout