


Map No. KANSAS Sec. 27 Twp. 21 R. 10^E
 Well No. 1-M^e Gray Farm
Phillips Pet Company

990 Ft. from N. Line
 _____ Ft. from S. Line
330 Ft. from E. Line
 _____ Ft. from W. Line

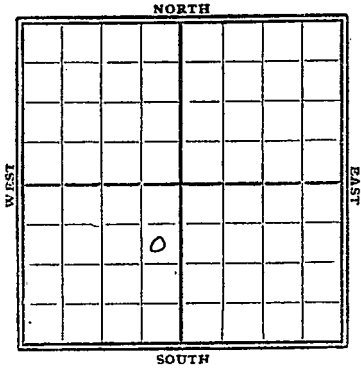

1929

| Date | REPORT |
|------|--------------------|
| 7/31 | Regrup. |
| 8/7 | Spdy. |
| 8/14 | Willy 800' |
| 8/21 | " 1465 |
| 8/28 | S.D. 1465 |
| 9/4 | S.D. 1747' |
| 9/11 | S.D. 1800' |
| 9/18 | |
| 9/25 | Idy shale 1974-92' |
| | Top time 2145' |
| | T.D. 2188' |
| | Dry & Abandoned |

Hyon

Map No. KANSAS Sec. 27 Twp. 21 R. 10

Well No. 21 *The Cray*

Phillips Pet Company
Contractor

COMPLETE

SECTION PLAT

990 Ft. from N. Line
 _____ Ft. from S. Line
330 Ft. from E. Line
 _____ Ft. from W. Line

| | | | |
|--|---|--|--|
| | | | |
| | | | |
| | o | | |
| | | | |

ABANDONED

Location _____

Rig up _____

Drilling and Remarks:

Sdy Shale 1974-92
Top line 2145

RECORD

Cased _____ in., _____ ft.
 Sand _____
 Gas _____
 Oil _____
 Total Depth 2188'

PRODUCTION

1st 24 hrs. Nat. _____
 1st 24 hrs. after shot _____
 Gas _____ Cu. Ft.
 Dry Hole
 Abandoned

Date
SEP 25 1929

CHAS. L. SHERWOOD

K21 **KANSAS** *Hyon.*
 Map No. _____ Sec. *27* Twp. *21* R. *10*^E
 Well No. *1* *The Cray*
Phillips Fuel Co Company
 _____ Contractor

FIRST REPORTS

990 Ft. from N. Line
 _____ Ft. from S. Line
330 Ft. from E. Line
 _____ Ft. from W. Line

SECTION PLAT

| | | | |
|--|--|---|--|
| | | | |
| | | | |
| | | o | |
| | | | |

Location _____

Rig up _____

Drilling and Remarks:

Rigging up.

RECORD

Cased _____ in., _____ ft.
 Sand _____
 Gas _____
 Oil _____
 Total Depth _____

PRODUCTION

1st 24 hrs. Nat. _____
 1st 24 hrs. after shot _____
 Gas _____ Cu. Ft.
 Dry Hole _____
 Abandoned _____

Date
JUL 31 1929

CHAS. L. SHERWOOD